

**SURVEY &
REMONUMENTATION**

OTTAWA COUNTY REMONUMENTATION

APR 05 1996

LAND CORNER RECORDATION CERTIFICATE
Filing Requirement of Act 74, Mich. P.A. 1970

COMMISSION

For corners in
OTTAWA
(County)

	Located In:	Corner Code #
1. Public Land Survey	T5N R15W	C-10 (E 1/4 cor Section 30) Holland Twp.
	T ___ R ___	_____
	T ___ R ___	_____
	T ___ R ___	_____
2. Property Controlling in Section	S ___ T ___ R ___	_____
	S ___ T ___ R ___	_____
3. Miscellaneous Property in Sec.	S ___ T ___ R ___	_____
	S ___ T ___ R ___	_____

RECORDED

95 NOV 15 PM 2:14

Dorothy Chittman
REGISTER OF DEEDS
OTTAWA COUNTY, MI

Register of Deeds Stamp & File Number

4. Lot No. _____, Recorded Plat _____
5. Private Claims _____

	A	B	C	D	E	F	G	H	I	J	K	L
2	6	5	4	3	2	1						
3												
4	7	8	9	10	11	12						
5												
6	18	17	16	15	14	13						
7												
8	19	20	21	22	23	24						
9												
10	30	29	28	27	26	25						
11												
12	31	32	33	34	35	36						
13												

I, Randal J. Vugteveen, in a field survey on October 17, 19 95, do hereby certify that under requirements of P.A. 74, Michigan P.A. of 1970, the corner points mentioned in lines 1 and 2 above were in conformance with regulations and rules therefore as required in the current manual of survey instructions of the United States Department of the Interior, Bureau of Land Management or by a decree of a Court of Law and/or that the corner points mentioned in lines 3, 4 and 5 above were in conformance with the rules of the Michigan Board of Land Surveyors or by a Decree of a Court of Law; established, re-established, monumented, re-monumented, recovered, found as expressed below:

NOTE: Not more than 4 corners, all in the same town and range, may be recorded on this certificate.

A. Description of original monument and accessories and/or subsequent restoration:
C-10 Common corner to Sections 29 & 30


1832 - Lyon	SW corner of building N 33.35'
Set HMP	NE corner of building S 42.80'
Beech N31 W28 18 Links	Centerline hydrant NW 71.80'
Beech S17 E20 18 Links	

B. Description of corner evidence found and/or method applied in restoring or reestablishing corner:
C-10 Found 1" dia. iron in mon box 1' N of centerline W 8th St. & 25' E of centerline Graham St. and accepted as a careful and faithful perpetuation of the position of the original corner
Centerline hydrant NW 72.34'

P.A. 345 OTTAWA COUNTY
PEER APPROVED 10/23/95
Melody D. Hedewell
D D 7

C. Description of monument for corner and accessories established to perpetuate locating the position of the corner:
C-10 Removed 1" dia iron, set 3/4" X 24" solid bar with Ottawa County Remon cap in mon box

SW corner concrete foundation building AZ 0 deg 33.39'
NE corner building #220 W. 8th St. Az. 187 deg 42.81'
Top centerline hydrant Az. 292 deg 72.34'
NW corner block garage Az. 148 deg 104.39'

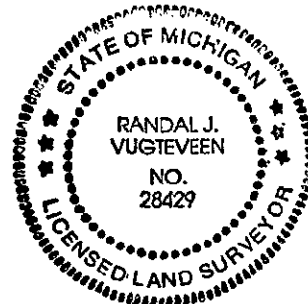

Signed by *Randal J. Vugteveen*
Surveyor's Michigan License No. 28429

Date Oct 20, 1995