

SURVEY & REMONUMENTATION

DEC 01 1998

**OTTAWA COUNTY REMONUMENTATION
LAND CORNER RECORDATION CERTIFICATE
Filing Requirement of Act 74, Mich. P.A. 1970**

SECTION

For corners in

OTTAWA

(County)

Located In:

Corner Code #

- | | | | |
|---------------------------------------|--------------|---------------|--|
| 1. Public Land Survey | T <u>5</u> N | R <u>15</u> W | C-11 (NW corner
Section 32) Holland
Township |
| | T <u> </u> | R <u> </u> | _____ |
| | T <u> </u> | R <u> </u> | _____ |
| | T <u> </u> | R <u> </u> | _____ |
| 2. Property Controlling
in Section | S <u> </u> | T <u> </u> | _____ |
| | S <u> </u> | T <u> </u> | _____ |
| 3. Miscellaneous
Property in Sec. | S <u> </u> | T <u> </u> | _____ |
| | S <u> </u> | T <u> </u> | _____ |

RECORDED

98 MAR 16 PM 12:37

Dany [Signature]
REGISTER OF DEEDS
OTTAWA COUNTY, MI

Register of Deeds Stamp & File Number

4. Lot No. _____, Recorded Plat _____
5. Private Claims _____

I, Randal J. Vugteveen, in a field survey on December 3, 19 96 do hereby state that under requirements of P.A. 74, Michigan P.A. of 1970, the corner points mentioned in lines 1 and 2 above were in conformance with regulations and rules therefore as required in the current manual of survey instructions of the United States Department of the Interior, Bureau of Land Management or by a decree of a Court of Law and /or that the corner points mentioned in lines 3, 4 and 5 above were in conformance with the rules of the Michigan Board of Land Surveyors or by a Decree of a Court of Law; established, re-established, monumented, recovered, found as expressed below:

NOTE: Not more than 2 corners, all in the same town and range, may be recorded on this certificate.

	A	B	C	D	E	F	G	H	I	J	K	L	M
1													
2		6		5		4		3		2		1	
3													
4		7		8		9		10		11		12	
5													
6		18		17		16		15		14		13	
7													
8		19		20		21		22		23		24	
9													
10		30		29		28		27		26		25	
11													
12		31		32		33		34		35		36	
13													

A. Description of original monument and accessories and/or subsequent restoration:

- | | |
|--|---|
| C-11 Common corner to Sections 29, 30, 31 & 32 | N 1/4 corner Sec. 32 County Surveyor 2649.75' |
| 1832 - Lyon | N 1/4 corner Sec. 32 HEI 2650.99' |
| Set Corner | W 1/4 corner Sec. 32 County Surveyor 2636.0' |
| 15" Beech S72° E 12 Links | W 1/4 corner Sec. 32 HEI 2636.89' |
| 20" Beech N72° W 25 Links | |

B. Description of corner evidence found and/or method applied in restoring or reestablishing corner:

- | | | |
|--|--|---|
| C-11 - Found sawn off R.R. spike centerline "x" W 16th St. & Washington Ave. | Accepted railroad spike as a careful perpetuation of the position of the original corner | Removed railroad spike, set 3/4"x24" solid bar with Ottawa County Remon cap in monument box |
| North 1/4 corner Section 32, 2651.02' | | |
| West 1/4 corner Section 32, 2636.89' | | |
| Checks with plat R.O.W.s at 16th & Washington | | |


C. Description of monument for corner and accessories established to perpetuate locating the position of the corner:

- C-11 Iron bar with Ottawa County Remon cap in monument box

- NE foundation corner house #220 W 16th AZ 221° 70.45'
NW foundation porch corner house #208 W 16th AZ 120° 97.48'
SW foundation corner house #209 W 16th AZ 46° 78.07'
SE foundation corner house #225 W 16th AZ 302° 108.69'

P.A. 345 OTTAWA COUNTY

12/1/97

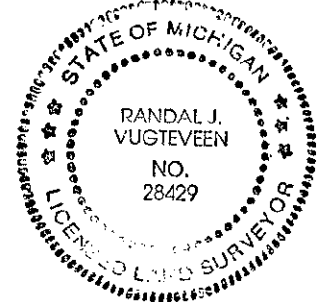

\$ 9.00 SURVEY
\$ 1.00 PHOTO

Signed by Randal J. Vugteveen
Surveyor's Michigan License No. 28429

Date Dec. 1, 1997