

FEB 24 2000

OTTAWA COUNTY REMONUMENTATION
LAND CORNER RECORDATION CERTIFICATE
Filing Requirement of Act 74, Mich. P.A. 1970

RECORDED

99 OCT 27 PM 1:48

SECTION

For corners in
Ottawa
(County)

Located In:

Corner Code #

- 1. Public Land Survey T5N__ R15W__ C-12
T__ R__
T__ R__
T__ R__
T__ R__
- 2. Property Controlling S__ T__ R__
in Section S__ T__ R__
Holland Township
- 3. Miscellaneous S__ T__ R__
Property in Sec. S__ T__ R__

Greg Sublett
REGISTER OF DEEDS
OTTAWA COUNTY MI

Register of Deeds Stamp & File Number

- 4. Lot No. _____, Recorded Plat _____
- 5. Private Claims _____

	A	B	C	D	E	F	G	H	I	J	K	L	M
1													
2	6		5		4		3		2		1		
3													
4	7		8		9		10		11		12		
5													
6	18		17		16		15		14		13		
7													
8	19		20		21		22		23		24		
9													
10	30		29		28		27		26		25		
11													
12	31	32	33	34	35	36							
13													

I, Steve Lampen _____, in a field survey on September 14, 1999, do hereby certify that under requirements of P.A. 74, Michigan P.A. of 1970, the corner points mentioned in lines 1 and 2 above were in conformance with regulations and rules therefore as required in the current manual of survey instructions of the United States Department of the Interior, Bureau of Land Management or by a decree of a Court of Law and/or that the corner points mentioned in lines 3, 4 and 5 above were in conformance with the rules of the Michigan Board of Land Surveyors or by a Decree of a Court of Law; established, re-established, monumented, re-monumented, recovered, found as expressed below:

NOTE: Not more than 4 corners, all in the same town and range, may be recorded on this certificate.

A. Description of original monument and accessories and/or subsequent restoration:

- C-12 Peck - 1893 LCRC, L1, P359 - Ratekin - 1972
GLO - Brookfield - 1932 C-12 to C-11 = 2636 Found 2" square iron in monument box
Set 1/2 mile post C-12 to C-13 = 2644 Centerline fire hydrant S 35° W 44.1
Beech 20 S 45 E 20 Centerline manhole S 30° E 51.4
Elm 10 N 76 W 14 C-12 is shown on the Plat Elmwood Addition - 1904 Centerline manhole N 70° E 65.5
- LCRC, L 6, P 261 - Clapp - 1993
Found 2" iron in monument box
Nail and tag in SE side power pole SW 35.09
Nail and tag in 12" Maple NE 54.55
Centerline top hydrant SW 44.0
NE corner concrete house foundation SW 81.25
NW corner concrete house foundation SE 96.75

B. Description of corner evidence found and/or method applied in restoring or reestablishing corner:

C-12 Found 2" square iron in monument box. Centerline fire hydrant S 35° W 44.1, centerline manhole S 30° E 51.40, centerline manhole N 70° E 65.5, nail and tag in SE side power pole SW 35.09, nail and tag in 12" Maple NE 54.55, centerline top hydrant SW 44.0, NE corner concrete house foundation SW 81.25, NW corner Concrete house foundation SE 96.75

C-12 to C-11 Peck = 2636 meas. = 2636.89 C-12 to C-13 Peck = 2644 meas. = 2644.07


Found 2" Square iron fits the monumentation of Block B, Original Plat of Holland (1847), Elmwood Addition (1904) and many other more recent plats and surveys.

Replaced 2" square iron with an Ottawa County Remonumentation iron and cap and accepted it as a careful and Faithful perpetuation of the position of the original corner.

C. Description of monument for corner and accessories established to perpetuate locating the position of the corner:

- C-12 Ottawa County Remonumentation iron and cap in monument box
- Azimuth = Michigan State Plane grid direction
- Remonumentation tag in SE side 14" Maple 66° 07' 54.27
- Survey tag #14091 in SE side power pole 223° 36' 35.06
- NE corner house foundation 228° 46' 81.23
- SE corner house foundation 319° 34' 88.11
- NW corner house foundation 120° 14' 128.06
- NE corner porch foundation 129° 13' 102.96

9/20/99
SL

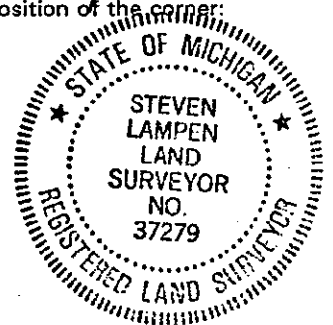

\$9.00 CORNER
Receipt #61757

Signed by Steven Lampen

Date OCTOBER 16, 1999

Surveyor's Michigan License No. 37279