

SURVEY & REMONUMENTATION

APR 05 1996

COMMISSION

OTTAWA COUNTY REMONUMENTATION

LAND CORNER RECORDATION CERTIFICATE
Filing Requirement of Act 74, Mich. P.A. 1970

For corners in OTTAWA
 (County)

Located In: Corner Code #
 1. Public Land Survey 5N 15W C-13 (SE cor
T R Section 31)
T R Holland Twp.
T R
 2. Property Controlling S T R
 in Section S T R
 3. Miscellaneous S T R
 Property in Sec. S T R

RECORDED

95 NOV 29 PM 1:43

Phyllis Kallman
 REGISTER OF DEEDS
 OTTAWA COUNTY, MI

Register of Deeds Stamp & File Number

4. Lot No. _____, Recorded Plat _____
 5. Private Claims _____

	A	B	C	D	E	F	G	H	I	J	K	L	M
2	6	5	4	3	2	1							
3													
4	7	8	9	10	11	12							
5													
6	18	17	16	15	14	13							
7													
8	19	20	21	22	23	24							
9													
10	30	29	28	27	26	25							
11													
12	31	32	33	34	35	36							
13													

I, Randal J. Vugteveen, in a field survey on October 19, 19 95, do hereby certify that under requirements of P.A. 74, Michigan P.A. of 1970, the corner points mentioned in lines 1 and 2 above were in conformance with regulations and rules therefore as required in the current manual of survey instructions of the United States Department of the Interior, Bureau of Land Management or by a decree of a Court of Law and/or that the corner points mentioned in lines 3, 4 and 5 above were in conformance with the rules of the Michigan Board of Land Surveyors or by a Decree of a Court of Law; established, re-established, monumented, re-monumented, recovered, found as expressed below:

NOTE: Not more than 4 corners, all in the same town and range, may be recorded on this certificate.

A. Description of original monument and accessories and/or subsequent restoration:

C-13 Common corner to Sections 31 & 32

1832 - Lyon		Iron in Mon Box
Set post		MDOT tag in P.P. ENE 68.10'
Beech N71 E54 7 Links		Centerline top of hydrant NE 71.05'
Ironwood N50 W8 5 Links		Centerline steel light p NW 42.40'
		NE cor brick building WSW 81.80'

B. Description of corner evidence found and/or method applied in restoring or reestablishing corner:


C-13 Found 1" iron in mon box on centerline W 32nd St. & 5' East of centerline Washington Ave South and accepted as a careful and faithful perpetuation of the position of the original corner
 MDOT tag in p. pole 69 deg 68.13'
 C/L top of hydrant NE 70.86'
 C/L steel light pole NW 42.57'
 NE cor brick bldg #774 WSW 81.55'

P.A. 345 OTTAWA COUNTY
 PEER APPROVED 11/20/95

Randal J. Vugteveen
JDN

C. Description of monument for corner and accessories established to perpetuate locating the position of the corner:

C-13 Removed 1" X 24" solid bar, set 3/4" X 36" solid bar with Ottawa County Remon cap in mon box
 Found Ottawa County Remon Nail & Tag in E side 36" Maple Az. 339 deg 72.26'
 Set Ottawa County Remon Nail & Tag in S side p. pole Az. 70 deg 67.93'
 NW block corner building #777 Az. 116 deg 138.62'
 Iron in mon box Az. 261 deg 5.26' (Allegan Corner)

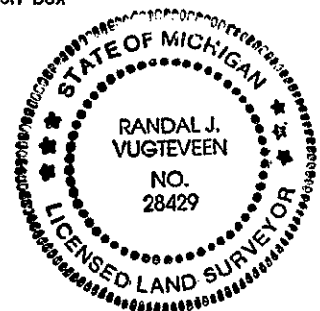

Signed by *Randal J. Vugteveen*
 Surveyor's Michigan License No. 28429

Date Nov. 20, 1995