

DEC 01 1998

RECORDED

SECTION

Ottawa County Remonumentation
LAND CORNER RECORDATION CERTIFICATE
Filing Requirement of Act 74, Mich. P.A. 1970

98 JUL 21 PM 12:14

For corners in

<u>Ottawa</u> (County)	Located In:	Corner Code #
1. Public Land Survey	T <u>5N</u> R <u>15W</u>	D-1 (N $\frac{1}{4}$, 5)
	T _____ R _____	Holland Twp.
	T _____ R _____	_____
	T _____ R _____	_____
2. Property Controlling in Section	S _____ T _____ R _____	_____
	S _____ T _____ R _____	_____
3. Miscellaneous Property in Sec.	S _____ T _____ R _____	_____
	S _____ T _____ R _____	_____
4. Lot No. _____, Recorded Plat _____		
5. Private Claims _____		

Gay Sublett
REGISTER OF DEEDS
OTTAWA COUNTY, MI

Register of Deeds Stamp & File Number

I, John C. Bueche, in a field survey on March 17, 19 98, do hereby certify that under requirements of P.A. 74, Michigan P.A. of 1970, the corner points mentioned in lines 1 and 2 above were in conformance with regulations and rules therefore as required in the current manual of survey instructions of the United States Department of the Interior, Bureau of Land Management or by a decree of a Court of Law and/or that the corner points mentioned in lines 3, 4 and 5 above were in conformance with the rules of the Michigan Board of Land Surveyors or by a Decree of a Court of Law; established, re-established, monumented, re-monumented, recovered, found as expressed below:

A	B	C	D	E	F	G	H	I	J	K	L	M
2	6	5	4	3	2							
3												
4	7	8	9	10	11	12						
5												
6	16	17	16	15	14	13						
7												
8	19	20	21	22	23	24						
9												
10	30	29	28	27	26	25						
11												
12	31	32	33	34	35	36						
13												

NOTE: Not more than 4 corners, all in the same town and range, may be recorded on this certificate.

A. Description of original monument and accessories and/or subsequent restoration:

D-1 GLO
Did not set corner No information

RA. 345 OTTAWA COUNTY
PEER APPROVED 6-1-98
MDA


B. Description of corner evidence found and/or method applied in restoring or reestablishing corner:

D-1 Found broken 4" Harrison Mon. in Mon. Box, 0.21' South of Township Line D-13 (S 1/4 32) & E-13 (SE 32) 6-15 down 0.75' below grade; on C/L bit. road E & W
No cover

This position not established by original government surveyors.
This monument is accepted as the best available evidence of the position of the corner.

C. Description of monument for corner and accessories established to perpetuate locating the position of the corner:

D-1 Set 3/4" x 24" pin with Ottawa Co. Cap on Township Line, N edge of Mon. Box;
Note: Point is NOT in center of cap (left mon. in place)
Ottawa Co. Remon. Tag & Nail in NW cor. wooden bridge deck N 55° W 35.93'
Ottawa Co. Remon. Tag & Nail in SW cor. wooden bridge deck S 60° W 36.21'
Ottawa Co. Remon. Tag & Nail in NW side 18" Catalpa S 80° W 118.21'
Ottawa Co. Remon. Tag & Nail in E side PP S 20° W 132.39'
Ottawa Co. Remon. Tag & Nail in E side 12" Ash S 70° E 93.56'
C/L drain South, West 20'±
On C/L bit. road E-W
Ottawa Co. Mon. in Mon. Box West 70.99' D-13 (S 1/4 32, 6-15)

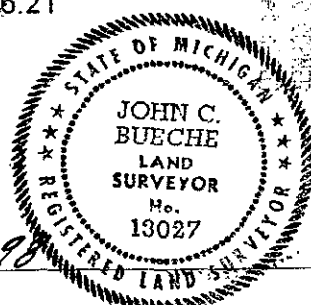

Signed by John C. Bueche, P.S. 13027 Date 4-1-98
Surveyor's Michigan License No. _____

DEC 01 1998

SECTION

