

1993

OTTAWA COUNTY REMONUMENTATION

RECORDED

COMMISSION

LAND CORNER RECORDATION CERTIFICATE  
Filing Requirement of Act 74, Mich. P.A. 1970

93 DEC 15 AM 9:26

For corners in OTTAWA  
(County)

Located in:


Corner Code #

- |                                       |   |    |   |     |                |
|---------------------------------------|---|----|---|-----|----------------|
| 1. Public Land Survey                 | T | 5N | R | 15W | D-5 (S 1/4 cor |
|                                       | T |    | R |     | Section 8)     |
|                                       | T |    | R |     | Holland Twp.   |
|                                       | T |    | R |     |                |
| 2. Property Controlling<br>in Section | S |    | T | R   |                |
|                                       | S |    | T | R   |                |
| 3. Miscellaneous<br>Property in Sec.  | S |    | T | R   |                |
|                                       | S |    | T | R   |                |

*Randy J. Vugteveen*  
REGISTER OF DEEDS  
OTTAWA COUNTY, MI

Register of Deeds Stamp & File Number

4. Lot No. \_\_\_\_\_, Recorded Plat \_\_\_\_\_
5. Private Claims \_\_\_\_\_

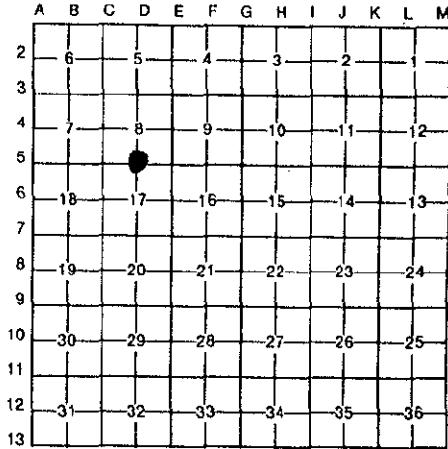

I, Randal J. Vugteveen, in a field survey on November 18, 19 93, do hereby certify that under requirements of P.A. 74, Michigan P.A. of 1970, the corner points mentioned in lines 1 and 2 above were in conformance with regulations and rules therefore as required in the current manual of survey instructions of the United States Department of the Interior, Bureau of Land Management or by a decree of a Court of Law and/or that the corner points mentioned in lines 3, 4 and 5 above were in conformance with the rules of the Michigan Board of Land Surveyors or by a Decree of a Court of Law; established, re-established, monumented, re-monumented, recovered, found as expressed below:

**NOTE: Not more than 4 corners, all in the same town and range, may be recorded on this certificate.**

A. Description of original monument and accessories and/or subsequent restoration:


D-5 LCRC Liber 2, Page 25	D-5 LCRC Liber 3, Page 127	D-5 LCRC Liber 5, Page 17
Found Iron pipe	Iron Pipe	Set cast mon / SSW 141.40' to nail and washer in E side PP / SW 42.36' to st. sign / SSE 76.24' to PK in W of 6" Elm / SSE 117.31' to NW cor hse foundation / NE 95.89' to PK in S side 14" Apple
P.P. SW 141.42'	P. Pole SE 38.55'	
Tel. Pole SE 36.82'	St. Sign SW 42.40'	
12" Apple NE 95.11'	Iron stake SW 46.16'	
NW house corner SE 117.09'	NW cor hse fnd SSE 117.28'	

B. Description of corner evidence found and/or method applied in restoring or reestablishing corner:  
Found rod in mon box at centerline Riley Street and 132nd Avenue and accepted as a careful and faithful perpetuation of the position of the original corner

NW house corner SE 117.09'	Iron Stake SW 46.16'	SW 42.36' to st. sign W of 6" Elm SSE 76.24'
----------------------------	----------------------	---

C. Description of monument for corner and accessories established to perpetuate locating the position of the corner:  
Set Ottawa County Remon Cap on 24" X 3/4" solid rod

- Set "X" in top E end 24" conc culvert N43E 34.43'
- Set Ottawa County Remon Tag & Nail in SW side P. Pole N39W 38.43'
- NE fnd cor #3167 S45W 132.42'
- Top center of hydrant S32E 60.38'

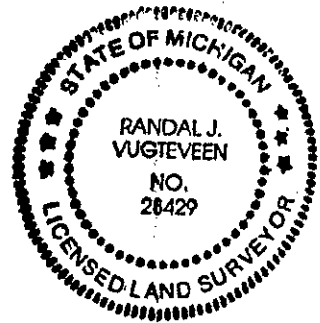

Signed by *Randal J. Vugteveen*  
Surveyor's Michigan License No. 28429

Date Dec 6, 1993