

**OTTAWA COUNTY REMONUMENTATION  
LAND CORNER RECORDATION CERTIFICATE**  
Filing Requirement of Act 74, Mich. P.A. 1970

For corners in <u>Ottawa</u> <small>(County)</small>	Located In:	Corner Code #
1. Public Land Survey	T5N ___ R15W ___ T ___ R ___ T ___ R ___ T ___ R ___	D-9 S 1/4 cor. Sec. 20 Holland Twp.
2. Property Controlling in Section	S20 ___ T5N ___ R15W ___ S ___ T ___ R ___	_____
3. Miscellaneous Property in Sec.	S ___ T ___ R ___ S ___ T ___ R ___	_____

**RECORDED**  
96 DEC 20 PM 12: 21  
*Phyllis Hillman*  
REGISTER OF DEEDS  
OTTAWA COUNTY, MI  
**Register of Deeds Stamp & File Number**

4. Lot No. \_\_\_\_\_, Recorded Plat \_\_\_\_\_  
5. Private Claims \_\_\_\_\_

I, Steven Lampen, in a field survey on December 5, 1996, do hereby certify that under requirements of P.A. 74, Michigan P.A. of 1970, the corner points mentioned in lines 1 and 2 above were in conformance with regulations and rules therefore as required in the current manual of survey instructions of the United States Department of the Interior, Bureau of Land Management or by a decree of a Court of Law and/or that the corner points mentioned in lines 3, 4 and 5 above were in conformance with the rules of the Michigan Board of Land Surveyors or by a Decree of a Court of Law; established, re-established, monumented, re-monumented, recovered, found as expressed below:

**NOTE: Not more than 4 corners, all in the same town and range, may be recorded on this certificate.**

1	A	B	C	D	E	F	G	H	I	J	K	L	M
2		6	5	4	3	2	1						
3													
4		7	8	9	10	11	12						
5													
6		18	17	16	15	14	13						
7													
8		19	20	21	22	23	24						
9													
10		30	29	28	27	26	25						
11													
12		31	32	33	34	35	36						
13													

**A. Description of original monument and accessories and/or subsequent restoration:**

D-9  
GLO - Brookfield - 1832  
East on ran between Sections 20 and 29  
40.00' temporary 1/4 section post in lake  
65.36' left lake  
80.03' East line at post - land marshy  
Corrected West  
14.67' to lake and set post, no timber near  
40.01' 1/4 section post in lake  
80.03 section corner on lake shore

Section line between Sections 20 and 29 with reference to D-9 is shown on Assessor's Plat No. 1 - 1937. Did not use this reference as it seems to be taken from the original Plat of Holland which does not show the section line or D-9. The North and South 1/4 line of Section 20 is shown of the Plats of Howard's Addition - 1872, River Hills Subdivision - 1941 and River Hills Subdivision No. 2 - 1944.

**B. Description of corner evidence found and/or method applied in restoring or reestablishing corner:**

D-9  
Calculated position of D-9 by using the Plats of Howard's Addition, River Hills Subdivision and River Hills Subdivision No. 2, for East and West location and used a straight line between C-9 and E-9 for North and South location. See sketch on back.

Set Ottawa County Remonumentation iron and cap as a reference monument at the intersection of the North and South 1/4 line of Section 20 with the centerline of River Hills Drive.


Calculated position of D-9 is accepted as a careful and faithful re-establishment of the position of the original corner.

P.A. 345 OTTAWA COUNTY  
PEER APPROVED 12-9-96  
*J.D.V.*

**C. Description of monument for corner and accessories established to perpetuate locating the position of the corner:**

D-9 See sketch on back. Azimuths = Michigan State Plan grid direction  
Reference monument - Ottawa County Remonumentation iron and cap at the intersection of the North and South 1/4 line of Section 20 with the centerline of River Hills Drive.

Remon. tag in W side 18" Oak	332° 19'	113.59'
SW corner brick wall, house #79	53° 00'	99.82'
Hydrant, top, centerline	81° 20'	48.35'
NW corner house No. 82, brick	134° 57'	215.13'
Centerline manhole	223°	2.1'
D-9 = calculated position	180° 36' 24"	1141.99'
D-8 = iron	0° 36' 24"	1475.00'

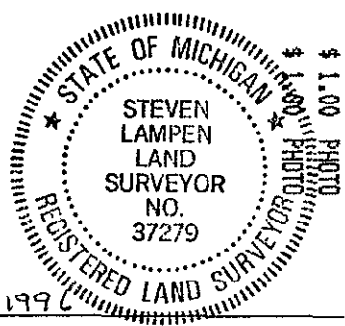

Signed by Steven Lampen Date DECEMBER 13, 1996

Surveyor's Michigan License No. 37279

FORM APPROVED BY MICHIGAN STATE BOARD OF LAND SURVEYORS, JAN. 28, 1971  
REVISED MAY 14, 1971  
REVISED JAN., 1986  
ADAPTED FOR WORD PROCESSING MARCH, 1986

