

SURVEY & REMONUMENTATION

FEB 27 1998

SECTION

**OTTAWA COUNTY REMONUMENTATION
LAND CORNER RECORDATION CERTIFICATE
Filing Requirement of Act 74, Mich. P.A. 1970**

For corners in
Ottawa Located In: Corner Code #
(County)

1. Public Land Survey T5N R15W D-11
T R N 1/4 cor. Sec. 32
T R Holland Twp.
T R
T R

2. Property Controlling S T R
in Section S T R

3. Miscellaneous S T R
Property in Sec. S T R

4. Lot No. _____, Recorded Plat _____

5. Private Claims _____

RECORDED
97 DEC -8 AM 11:27

Don [Signature]
REGISTER OF DEEDS
OTTAWA COUNTY, MI

Register of Deeds Stamp & File Number

I, Steve Lampen, in a field survey on November 19 97, do hereby certify that under requirements of P.A. 74, Michigan P.A. of 1970, the corner points mentioned in lines 1 and 2 above were in conformance with regulations and rules therefore as required in the current manual of survey instructions of the United States Department of the Interior, Bureau of Land Management or by a decree of a Court of Law and/or that the corner points mentioned in lines 3, 4 and 5 above were in conformance with the rules of the Michigan Board of Land Surveyors or by a Decree of a Court of Law, established, re-established, monumented, re-monumented, recovered, found as expressed below:

NOTE: Not more than 4 corners, all in the same town and range, may be recorded on this certificate.

A. Description of original monument and accessories and/or subsequent restoration:

D-11 G.L.O Brookfield, 1832
28" Elm S 69 E 10 links
10" Hemlock N 11 W 10 links
set the 1/4 section corner post

D-11 is shown on the plats of:
Post's First Addition 1842, Liber 3, Page 12
Vanderberge's Plat, 1890, Liber 2, Page 24
Assessor's Plat No. 2, 1937, Liber 9, Page 41
Original plat of Holland, 1847,

L-2 Page 139, 1973
Found 1" pipe
Guy pole Northeast 35.32'
Power pole Southwest 32.40'
21" Elm Southeast 42.61'

B. Description of corner evidence found and/or method applied in restoring or reestablishing corner:

D-11
Found steel bar at the centerline of 16th Street and Central Ave.
The position of this corner fits the monumentation of the Plats: Post's First Addition, Vanderberge's Plat, Assessor's Plat NO. 2. and the original plat of Holland Replaced steel bar with Ottawa County Remonumentation iron and cap is accepted as a careful and faithful perpetuation of the position of the original corner.

C. Description of monument for corner and accessories established to perpetuate locating the position of the corner:


D-11
Set Ottawa County Remonumentation iron and cap in set monument box
AZ = Michigan State Plane grid direction

Northeast corner building brick	335° 35'	96.27'
Southeast corner building brick	312° 41'	55.15'
Hydrant top	33° 28'	41.85'
Northwest corner concrete step	36° 28'	69.48'
Northeast corner porch foundation	122° 02'	88.09'
Northeast corner building brick	209° 27'	121.79'
Southeast corner building brick	202° 29'	158.13'

	A	B	C	D	E	F	G	H	I	J	K	L
1												
2	6		5		4		3		2		1	
3												
4	7		6		9		10		11		12	
5												
6	18		17		16		15		14		13	
7												
8	19		20		21		22		23		24	
9												
10	30		29		28		27		26		25	
11												
12	31		32		33		34		35		36	
13												

**P.A. 345 OTTAWA COUNTY
PEER APPROVED 12-1-97**

A.D.N.

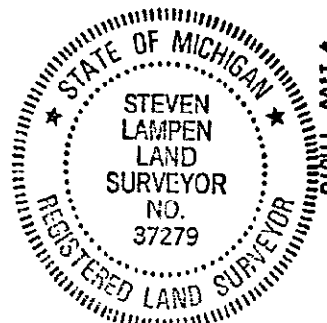

Signed by Steven Lampen Date DECEMBER 1, 1997
Surveyor's Michigan License No. 37279