

SURVEY & REMONUMENTATION

DEC 01 1998

Ottawa County Remonumentation
LAND CORNER RECORDATION CERTIFICATE
 Filing Requirement of Act 74, Mich. P.A. 1970

RECORDED
 98 MAY 22 PM 4:06

SECTION

For corners in

<u>Ottawa</u> (County)	Located In:	Corner Code #
1. Public Land Survey	T <u>5N</u> R <u>15W</u>	<u>E-1 (NW, 4)</u>
	T _____ R _____	<u>Holland Twp.</u>
	T _____ R _____	_____
	T _____ R _____	_____
2. Property Controlling in Section	S _____ T _____ R _____	_____
	S _____ T _____ R _____	_____
3. Miscellaneous Property in Sec.	S _____ T _____ R _____	_____
	S _____ T _____ R _____	_____
4. Lot No. _____, Recorded Plat _____		
5. Private Claims _____		

Ray [Signature]
 REGISTER OF DEEDS
 OTTAWA COUNTY, MI

Register of Deeds Stamp & File Number

I, John C. Bueche, in a field survey on March 17, 19 98, do hereby certify that under requirements of P.A. 74, Michigan P.A. of 1970, the corner points mentioned in lines 1 and 2 above were in conformance with regulations and rules therefore as required in the current manual of survey instructions of the United States Department of the Interior, Bureau of Land Management or by a decree of a Court of Law and/or that the corner points mentioned in lines 3, 4 and 5 above were in conformance with the rules of the Michigan Board of Land Surveyors or by a Decree of a Court of Law; established, re-established, monumented, re-monumented, recovered, found as expressed below:

NOTE: Not more than 4 corners, all in the same town and range, may be recorded on this certificate.

	A	B	C	D	E	F	G	H	I	J	K	L	M
2	6			5	4		3			2		1	
3													
4	7			8	9		10			11		12	
5													
6	18			17	16		15			14		13	
7													
8	19			20	21		22			23		24	
9													
10	30			29	28		27			26		25	
11													
12	31			32	33		34			35		36	
13													

A. Description of original monument and accessories and/or subsequent restoration:

E-1 GLO Lucius Lyon, 1831 North boundary 1.18 East of post, set cors. 4 & 5 Sycamore 40 S 70 W 7 Elm 24 S 64 E 12	LCRC L2, P681, Oct., 1974 Fnd. bent angle iron Olive Twp. cor. W 70.25' 20" Maple SE 50.82' 18" Ash SE 60.42' 18" Ash SE 67.26' C/L hydt. NW 48.14'	LCRC L5, P213, May, 1985 Set CIM Olive Twp. cor. W 70.24' 28" Maple ESE 87.73' 22" Ash SE 61.16' Top C/L of hydt. NW 48.15'
--	---	--

B. Description of corner evidence found and/or method applied in restoring or reestablishing corner:

E-1 Found 4" Harrison Mon. in Mon. Box, 0.41' North of Township line E-13 (SE 32) & F-13 (S 1/4 33) 6-15
 On C/L bit. road E-W & S


18" Ash SE 67.26'± C/L hydt. NW 48.14'±	28" Maple ESE 87.73'± C/L hydt. NW 48.15'±
--	---

And is accepted as a careful and faithful perpetuation of the position of the original corner.

PA. 345 OTTAWA COUNTY
 PEER APPROVED 4/20/98

C. Description of monument for corner and accessories established to perpetuate locating the position of the corner:

E-1 Set 3/4" x 24" pin with Ottawa Co. Cap in bit. on Township Line (Set PK 1.0' S & 1.0' W)
 Ottawa Co. Remon. Tag & Nail in W side PP S 10° W 286.73'
 Ottawa Co. Remon. Tag & Nail in N side 24" Maple S 50° E 67.56'
 Ottawa Co. Remon. Tag & Nail in Twin 8" Ash S 79° W 129.05'
 "X" cut in N end conc. culvt. N 55° E 40.29'
 C/L hydt. N 49° W 48.44'
 On C/L bit. road E-W & S
 Ottawa Co. Mon. West 70.25' E-13 (SE 32, 6-15)
 Mon. in Mon. Box North 0.41'

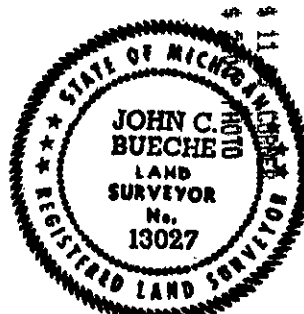

Signed by John C. Bueche Date 4-1-98
 John C. Bueche, P.S. 13027
 Surveyor's Michigan License No. _____

SURVEY &
REMONUMENTATION

DEC 01 1998

SECTION

