


*Randy J. Vugteveen*  
REGISTER OF DEEDS  
OTTAWA COUNTY, MI

For corners in OTTAWA

(County)	Located In:	Corner Code #
1. Public Land Survey	T <u>5N</u> R <u>15W</u>	E-3 (SE cor of section 5) Holland Twp
	T _____ R _____	_____
	T _____ R _____	_____
	T _____ R _____	_____
2. Property Controlling in Section	S _____ T _____ R _____	_____
	S _____ T _____ R _____	_____
3. Miscellaneous Property in Sec.	S _____ T _____ R _____	_____
	S _____ T _____ R _____	_____
4. Lot No. _____, Recorded Plat _____		
5. Private Claims _____		

Register of Deeds Stamp & File Number

I, Randal J. Vugteveen, in a field survey on November 18, 1993, do hereby certify that under requirements of P.A. 74, Michigan P.A. of 1970, the corner points mentioned in lines 1 and 2 above were in conformance with regulations and rules therefore as required in the current manual of survey instructions of the United States Department of the Interior, Bureau of Land Management or by a decree of a Court of Law and/or that the corner points mentioned in lines 3, 4 and 5 above were in conformance with the rules of the Michigan Board of Land Surveyors or by a Decree of a Court of Law; established, re-established, monumented, re-monumented, recovered, found as expressed below:

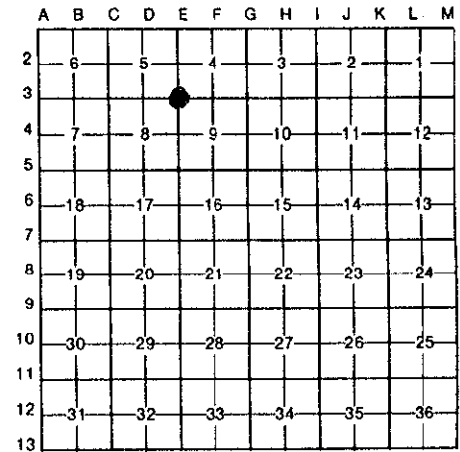

**NOTE: Not more than 4 corners, all in the same town and range, may be recorded on this certificate.**

A. Description of original monument and accessories and/or subsequent restoration:

E-3 LCRC Liber 3, Page 157	E-3 LCRC Liber 3, Page 325	E-3 LCRC Liber 3, Page 282
Angle Iron	Angle Iron	Angle Iron
Power Pole SE 60.77'	Power Pole SE 60.77'	Power Pole SE 60.77'
Power Pole NE 56.81'	Power Pole NE 56.81'	Power Pole NE 56.81'
	Power Pole SW 75.65'	Power Pole SW 75.65'
	Guy Pole NW 68.99'	Guy Pole NW 68.99'

B. Description of corner evidence found and/or method applied in restoring or reestablishing corner:


E-3 Found CIM in mon box at Centerline X of Quincy St. & 128th Avenue and accepted as a careful and faithful perpetuation of the position of the original corner

Power Pole SE 60.69'
Power Pole NE 56.78'
Power Pole SW 75.58'
Guy Pole RLS 14091 68.90'

C. Description of monument for corner and accessories established to perpetuate locating the position of the corner:

E-3 Cast Iron Monument

- Set Ottawa County Remon Tag & Nail in SW side guide pole N55W 68.72'
- Set Ottawa County Remon Tag & Nail in S side guide pole N54E 56.78'
- Set Ottawa County Remon Tag & Nail in S side P. Pole S63E 60.69'
- Set Ottawa County Remon Tag & Nail in NW side P. Pole S37W 75.57'

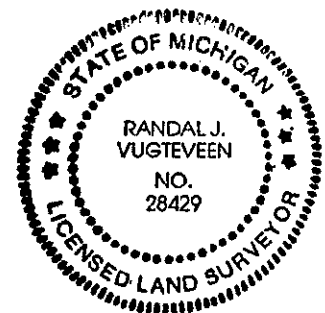

Signed by *Randal J. Vugteveen*  
Surveyor's Michigan License No. 28429

Date Dec 6, 1993