

FEB 24 2000

OTTAWA COUNTY REMONUMENTATION
LAND CORNER RECORDATION CERTIFICATE

RECORDED
99 OCT 27 PM 1:49

SECTION

Filing Requirement of Act 74, Mich. P.A. 1970

Ray Schultz
REGISTER OF DEEDS
OTTAWA COUNTY, MI

For corners in
Ottawa _____
(County)

Located In: Corner Code #

1. Public Land Survey T5N R15W E-7
T R
T R NW corner
T R Section 21
Holland Twp.

2. Property Controlling S T R
in Section S T R
Miscellaneous S T R
Property in Sec. S T R

Register of Deeds Stamp & File Number

4. Lot No. _____, Recorded Plat _____
5. Private Claims _____

I, Steve Lampen _____, in a field survey on September 15, 1999, do hereby certify that under requirements of P.A. 74, Michigan P.A. of 1970, the corner points mentioned in lines 1 and 2 above were in conformance with regulations and rules therefore as required in the current manual of survey instructions of the United States Department of the Interior, Bureau of Land Management or by a decree of a Court of Law and/or that the corner points mentioned in lines 3, 4 and 5 above were in conformance with the rules of the Michigan Board of Land Surveyors or by a Decree of a Court of Law; established, re-established, monumented, re-monumented, recovered, found as expressed below:

	A	B	C	D	E	F	G	H	I	J	K	L	M
1													
2	6	5	4	3	2	1							
3													
4	7	8	9	10	11	12							
5													
6	18	17	16	15	14	13							
7													
8	19	20	21	22	23	24							
9													
10	30	29	28	27	26	25							
11													
12	31	32	33	34	35	36							
13													

NOTE: Not more than 4 corners, all in the same town and range, may be recorded on this certificate.

A. Description of original monument and accessories and/or subsequent restoration:

E-7 E-7 is shown on Plats of
GLO - Brookfield - 1832 Oak Park Hills - 1961
Set corner to Sections 16, 17 Dunbrook Acres No. 2 - 1981
20 and 21
Hemlock 10 S 88 W 14 L.C.R.C. - L2, P25 - Clapp - 1973
Hemlock 8 E 17 Found iron pipe
E. Peck - 1900 26" Oak NE 81.67
Iron and stone 16" Oak NW 68.34
E-7 to D-7 = 2630 16" Oak WNW 57.25
E-7 to E-8 = 2659 Iron S 33'

Old County Records
E-7 to F-7 = 2669.8

B. Description of corner evidence found and/or method applied in restoring or reestablishing corner:

E-7 Found 3/4" iron in monument box 26" Oak NE 81.67
E-7 to D-7 - Peck = 2630, meas. 2623.31 E-7 to F-7 - rec. 2669.8, meas. 2678.18
E-7 to E-8 - Peck = 2659, meas. 2659.63

The position of the found iron fits the monumentation of Dunbrook Acres No. 2 and many other plats and surveys. The monumentation of Oak Park Hills fits a position approximately 9 ft. East of the found iron.


Replaced the found iron with an Ottawa County Remonumentation iron and cap and accepted it as the best position of the corner.

C. Description of monument for corner and accessories established to perpetuate locating the position of the corner:

E-7 Ottawa County Remonumentation iron and cap in monument box
Azimuth = Michigan State Plane grid direction

Remonumentation tag in N side Power pole	262° 33'	143.53
Remonumentation tag in S side Power pole	98° 32'	188.77
Survey tag #14091 in SE side 26" Oak	59° 06'	82.70
SW corner garage foundation	21° 08'	109.85
SE corner porch foundation	316° 12'	156.15
Hydrant, top centerline	284° 30'	151.67

10/18/99
SL

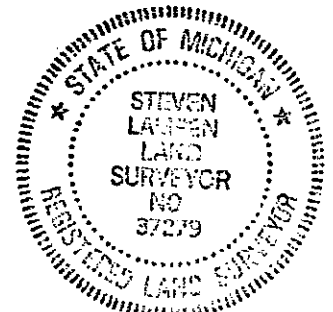

Signed by Steven Lampen Date OCTOBER 25, 1999

Surveyor's Michigan License No. 37279

Receipt #61757