

SURVEY & REMONUMENTATION

DEC 16 1996

COMMISSION

**OTTAWA COUNTY REMONUMENTATION
LAND CORNER RECORDATION CERTIFICATE
Filing Requirement of Act 74, Mich. P.A. 1970**

For corners in

OTTAWA

(County)

Located In:

Corner Code #

1. Public Land Survey

T 5N R 15W

E-8 (E 1/4 cor
Section 20) Holland
Twp.

2. Property Controlling
in Section

S T R
S T R

3. Miscellaneous
Property in Sec.

S T R
S T R

4. Lot No. , Recorded Plat
5. Private Claims

Randal J. Vugteveen

I, Randal J. Vugteveen, in a field survey on September 4, 19 96 do hereby state that under requirements of P.A. 74, Michigan P.A. of 1970, the corner points mentioned in lines 1 and 2 above were in conformance with regulations and rules therefore as required in the current manual of survey instructions of the United States Department of the Interior, Bureau of Land Management or by a decree of a Court of Law and for that the corner points mentioned in lines 3, 4 and 5 above were in conformance with the rules of the Michigan Board of Land Surveyors or by a Decree of a Court of Law; established, re-established, monumented, recovered, found as expressed below:

NOTE: Not more than 2 corners, all in the same town and range, may be recorded on this certificate.

RECORDED

95 NOV 14 AM 11:19

R. J. Vugteveen
REGISTER OF DEEDS
OTTAWA COUNTY, MI

Register of Deeds Stamp & File Number

	A	B	C	D	E	F	G	H	I	J	K	L	M
1													
2	6	5	4	3	2	1							
3													
4	7	8	9	10	11	12							
5													
6	18	17	16	15	14	13							
7													
8	19	20	21	22	23	24							
9													
10	30	29	28	27	26	25							
11													
12	31	32	33	34	35	36							
13													

A. Description of original monument and accessories and/or subsequent restoration:

E-8 Common corner to Sections 20 & 21
1832 - Brookfield
Set post
Red Oak S22 E80 20 Links
Red Oak N880 E86 7 Links

Liber 4, Page 172
Square Head Bolt / T. pole nail in face E 54.52' / P. pole nail in face WSW 107.30' / North edge North rail S 24.75'
P. pole ESE 108.90' / Centerline top hydrant N / 63.84' / P. pole nail in SW side SE 92.24' / P. pole PK in N side WSW 107.79'

Liber 2, Page 805
PK nail in asphalt / N. edge N. rail S 24.39' / T. pole W 55.21'
T. pole SE 55.00' / T. pole SE 98.44'

B. Description of corner evidence found and/or method applied in restoring or reestablishing corner:

E-8 Set monument box and reset corner by witnesses taken prior to construction as requested by Ottawa Co Road Commission and accepted as a careful and faithful perpetuation of the position of the original corner


T. pole nail in face E 54.52'
North edge North rail S 24.75'
P. pole ESE 108.90'

P.A. 345 OTTAWA COUNTY
PEER APPROVED 10-21-96
M. D. K.

C. Description of monument for corner and accessories established to perpetuate locating the position of the corner:

E-8 Set 3/4" X 24" solid bar with Ottawa County Remon Cap in mon box

Set Ottawa County Remon Nail & Tag in W side of 12" Pine Az 180 deg 107.89'
Set Ottawa County Remon Nail & Tag in N side of power pole Az 254 deg 115.22'
Set Ottawa County Remon Nail & Tag in E side power pole Az 355 deg 64.82'
Set Ottawa County Remon Nail & Tag in NE side power pole Az 137 deg 92.80'
Centerline Lakewood Blvd Az 0 deg 33'

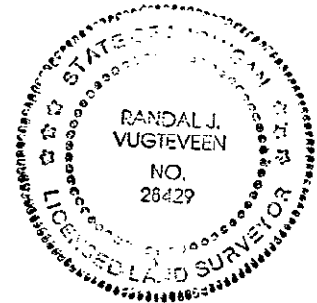

Signed by *Randal J. Vugteveen*
Surveyor's Michigan License No. 28429

Date SEPT. 16, 1996 1.55
9.00