

SURVEY & REMONUMENTATION

APR 05 1996

COMMISSION

OTTAWA COUNTY REMONUMENTATION

LAND CORNER RECORDATION CERTIFICATE

Filing Requirement of Act 74, Mich. P.A. 1970

For corners in OTTAWA
(County)

	Located In:	Corner Code #
1. Public Land Survey	T <u>5N</u> R <u>15W</u>	E-11 (SE corner Section 29) Holland Twp.
	T _____ R _____	
	T _____ R _____	
	T _____ R _____	
2. Property Controlling in Section	S _____ T _____ R _____	
	S _____ T _____ R _____	
3. Miscellaneous Property in Sec.	S _____ T _____ R _____	
	S _____ T _____ R _____	


RECORDED

95 NOV 15 PM 2:12

R. J. Vugteveen
REGISTER OF DEEDS
OTTAWA COUNTY, MI

Register of Deeds Stamp & File Number

4. Lot No. _____, Recorded Plat _____
5. Private Claims _____

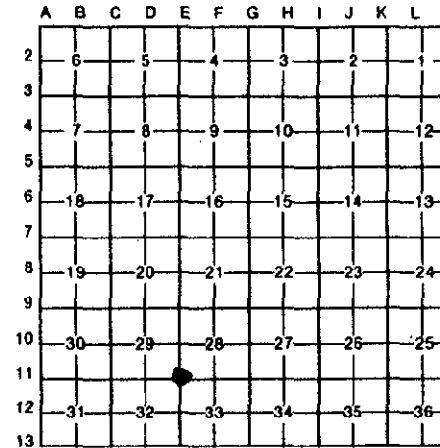

I, Randal J. Vugteveen, in a field survey on October 17, 19 95, do hereby certify that under requirements of P.A. 74, Michigan P.A. of 1970, the corner points mentioned in lines 1 and 2 above were in conformance with regulations and rules therefore as required in the current manual of survey instructions of the United States Department of the Interior, Bureau of Land Management or by a decree of a Court of Law and/or that the corner points mentioned in lines 3, 4 and 5 above were in conformance with the rules of the Michigan Board of Land Surveyors or by a Decree of a Court of Law; established, re-established, monumented, re-monumented, recovered, found as expressed below:

NOTE: Not more than 4 corners, all in the same town and range, may be recorded on this certificate.

A. Description of original monument and accessories and/or subsequent restoration:
E-11 Common corner to Sections 28, 29, 32 & 33

1832 - Lyon	Liber 2, Page 677	Liber 1, Page 691
Set corner	Found 3/4" iron pipe	1 1/2" iron
Beech N67 E10 10 Links	25" Maple SE 32.44'	Back cor walks N50W 46.47'
Beech S60 W9 4 Links	P. pole SW 41.37'	Back cor walks S45W 46.83'
	21" Maple NW 53.00'	Centerline hydrant N30E 43.80'
	P. pole NE 34.16'	


B. Description of corner evidence found and/or method applied in restoring or reestablishing corner:

E-11 Found OCRM cap cemented in mon box @ centerline "X" E 16th St. & Lincoln Ave and accepted as a careful and faithful perpetuation of the position of the original corner	
3/4" iron pipe	1 1/2" iron
25" Maple SE 32.44'	Back corner walks N50W 46.47'
P. pole SW 41.37'	Back corner walks S45W 46.83'
21" Maple NW 53.00'	
P. pole NE 34.16'	

P.A. 345 OTTAWA COUNTY
PEER APPROVED 10/23/95
Randal J. Vugteveen
RDJ

C. Description of monument for corner and accessories established to perpetuate locating the position of the corner:

E-11 Cast Iron Monument in mon box
NE corner brick house (not porch) #218 E. 16th St. Az. 223 deg 84.20'
NW corner stucco house #387 2' above walk by faucet Az. 132 deg 99.22'
SE foundation corner house #382 Lincoln (not porch) Az. 308 deg 72.26'
Set Ottawa County Remon Nail & Tag in E side p. pole Az. 28 deg 53.34'

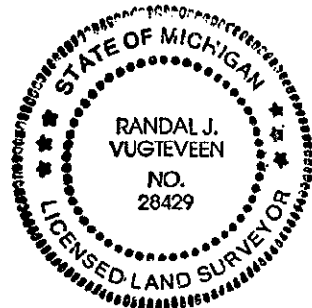

Signed by *Randal J. Vugteveen*
Surveyor's Michigan License No. 28429

Date OCT. 20, 1995