

FEB 24 2000

OTTAWA COUNTY REMONUMENTATION
LAND CORNER RECORDATION CERTIFICATE
Filing Requirement of Act 74, Mich. P.A. 1970

RECORDED
99 OCT 27 PM 1:48

SECTION

For corners in
ottawa _____ Located In: _____ Corner Code # _____
(County)

1. Public Land Survey T5N R15W E-12
T _____ R _____
T _____ R _____
T _____ R _____
T _____ R _____

2. Property Controlling S _____ T _____ R _____
in Section S _____ T _____ R _____

3. Miscellaneous S _____ T _____ R _____
Property in Sec. S _____ T _____ R _____

Greg S. Lamm
REGISTER OF DEEDS
OTTAWA COUNTY, MI

Register of Deeds Stamp & File Number

4. Lot No. _____, Recorded Plat _____
5. Private Claims _____

I, STEVE LAMPEN, in a field survey on SEPT. 14 1999, do hereby certify that under requirements of P.A. 74, Michigan P.A. of 1970, the corner points mentioned in lines 1 and 2 above were in conformance with regulations and rules therefore as required in the current manual of survey instructions of the United States Department of the Interior, Bureau of Land Management or by a decree of a Court of Law and/or that the corner points mentioned in lines 3, 4 and 5 above were in conformance with the rules of the Michigan Board of Land Surveyors or by a Decree of a Court of Law; established, re-established, monumented, re-monumented, recovered, found as expressed below:

A	B	C	D	E	F	G	H	I	J	K	L	M
1												
2	6	5	4	3	2	1						
3												
4	7	8	9	10	11	12						
5												
6	18	17	16	15	14	13						
7												
8	19	20	21	22	23	24						
9												
10	30	29	28	27	26	25						
11												
12	31	32	33	34	35	36						
13												

NOTE: Not more than 4 corners, all in the same town and range, may be recorded on this certificate.

A. Description of original monument and accessories and/or subsequent restoration:

E-12 GLO-Brookfield-1832 Set 1/2 Mile Post Beech 18 N79E 23 Beech 10 n46w 18	Peck-1893 E-12 to E-11 = 2644.8 E-12 to E-13 = 2641.5 E-12 to D-12 = 2654.25 E-12 is shown on Plat of Prospect Park Add. - 1905 South Prospect Park - 1907	LCRC L-2, P677 - Clapp 1974 Found 1/2" Iron Tel Pole S 66.33 18" Maple SW 70.31 P Pole NW 40.58 P Pole NE 79.68
		LCRC L-1, P695 - Spicer 1972 Found 1/2" Iron Cl Hydrant N60W 68.20 MBT Pole N05E 65.55 Guy Pole N45E 89.20

B. Description of corner evidence found and/or method applied in restoring or reestablishing corner:

E-12 Found concrete monument in monument box
18" Maple SW 70.31 P Pole NW 40.58

E-12 to E-11 Peck = 2644.8 Meas = 2643.44 E-12 to E-13 Peck = 2641.5 Meas = 2642.33
E-12 to D-12 Peck = 2654.25 Meas = 2655.43


Found concrete monument fits the monumentation of Prospect Park Addition, South Prospect Park, and many other plats and surveys and is accepted as a careful and faithful perpetuation of the position of the original corner.

C. Description of monument for corner and accessories established to perpetuate locating the position of the corner:

E-12 Concrete monument in monument box
Azimuth = Michigan State Plane Grid Direction

Survey Tag #14091 in S side Power Pole	121°14'	78.05
Remonumentation tag in SE side Power Pole	70°04'	69.80
Survey Tag #14091 in NE side Power Pole	310°42'	41.16
Survey Tag #14091 in NW side 18" Maple	238°19'	70.98
SW corner building, brick	69°00'	225.30
NE corner building, concrete	316°06'	153.45
NE corner building, foundation	200°12'	206.09
Hydrant, top centerline	291°29'	68.98

9/20/99
YDA

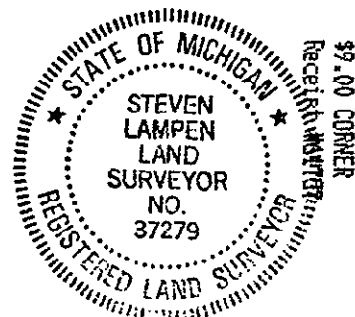

Signed by Steven Lampen Date OCTOBER 16, 1999
Surveyor's Michigan License No. 37279