

SURVEY & REMONUMENTATION

DEC 01 1998

SECTION

Ottawa County Remonumentation
LAND CORNER RECORDATION CERTIFICATE
 Filing Requirement of Act 74, Mich. P.A. 1970

RECORDED
 98 MAY 22 PM 4:06

Ray Roberts
 REGISTER OF DEEDS
 OTTAWA COUNTY, MI

For corners in

<u>Ottawa</u> (County)	Located In:	Corner Code #
1. Public Land Survey	T 5N R 15W	F-1 (N $\frac{1}{2}$, 4) Holland Twp.
	T _____ R _____	_____
	T _____ R _____	_____
	T _____ R _____	_____
2. Property Controlling in Section	S _____ T _____ R _____	_____
	S _____ T _____ R _____	_____
3. Miscellaneous Property in Sec.	S _____ T _____ R _____	_____
	S _____ T _____ R _____	_____

Register of Deeds Stamp & File Number

4. Lot No. _____, Recorded Plat _____
 5. Private Claims _____

I, John C. Bueche, in a field survey on March 19, 19 98, do hereby certify that under requirements of P.A. 74, Michigan P.A. of 1970, the corner points mentioned in lines 1 and 2 above were in conformance with regulations and rules therefore as required in the current manual of survey instructions of the United States Department of the Interior, Bureau of Land Management or by a decree of a Court of Law and/or that the corner points mentioned in lines 3, 4 and 5 above were in conformance with the rules of the Michigan Board of Land Surveyors or by a Decree of a Court of Law; established, re-established, monumented, re-monumented, recovered, found as expressed below:

	A	B	C	D	E	F	G	H	I	J	K	L	M
2	6		5		4		3		2		1		
3													
4	7		8		9		10		11		12		
5													
6	13		17		16		15		14		13		
7													
8	19		20		21		22		23		24		
9													
10	30		29		28		27		26		25		
11													
12	31		32		33		34		35		36		
13													

NOTE: Not more than 4 corners, all in the same town and range, may be recorded on this certificate.

A. Description of original monument and accessories and/or subsequent restoration:

F-1 GLO	LCRC L1, P397, May, 1972	LCRC L5, P213, May, 1985
Did not set corner	Fnd. angle iron	Fnd. angle iron set CIM
	TP SW 55.90'	PP SW 55.91'
	NE cor. hdwl. SE 23.10'	Olive Twp. cor. W 69.78'
		C/L st. sign NW 51.69'
		Nail in wood sign NW 52.54'

B. Description of corner evidence found and/or method applied in restoring or reestablishing corner:

F-1 Found broken 2" Harrison Mon. in Mon. Box, 0.10' South of Township line F-13 (S 1/4 33) & G-13 (SE 33) 6-15 on C/L bit. road E & W & gravel road South 1'± below grade

TP SW 55.90'±	Olive Twp. cor. W 69.78'
NE cor. hdwl. SE 23.10'	Wood sign NW 52.54'±

This position not established by original government surveyors.
 This monument is accepted as the best available evidence of the position of the corner.


P.A. 345 OTTAWA COUNTY

PEER APPROVED

4/20/98

C. Description of monument for corner and accessories established to perpetuate locating the position of the corner:

F-1 Set 3/4" x 24" pin with Ottawa Co. Cap (leaning) on Township Line, N edge of Mon. Box; Note: Point is NOT in center of cap (left mon. in place)
 Ottawa Co. Remon. Tag & Nail in E side PP S 18° W 55.93"
 "X" cut in E end conc. hdwl. S 50° E 38.25'
 "X" cut in N end conc. hdwl. S 48° W 34.11'
 "X" cut in W end conc. hdwl. N 53° E 31.35'
 SW cor. brick hse. N 8° E 250.49'
 On C/L bit. road E-W; on C/L gravel road South
 Ottawa Co. Mon. West 69.82' F-13 (S 1/4 33, 6-15)

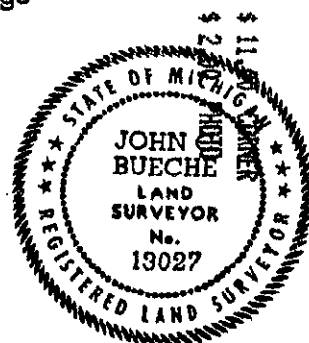

Signed by John C. Bueche, P.S. 13027

Date 4-1-98

SURVEY &
REMONUMENTATION

DEC 01 1998

SECTION

