

SURVEY & REMONUMENTATION

APR 24 1995

COMMISSION

For corners in
OTTAWA
(County)

OTTAWA COUNTY REMONUMENTATION

LAND CORNER RECORDATION CERTIFICATE Filing Requirement of Act 74, Mich. P.A. 1970

RECORDED

94 DEC 11 AM 9:43

Ralph A. Redmond
REGISTER OF DEEDS
OTTAWA COUNTY, MI

Located In: Corner Code #

- | | | |
|------------------------------------|-------------------------|--|
| 1. Public Land Survey | <u>5N</u> <u>15W</u> | <u>F-7 (S 1/4 cor</u>
<u>Section 16)</u>
<u>Holland Twp.</u> |
| | T _____ R _____ | |
| | T _____ R _____ | |
| | T _____ R _____ | |
| 2. Property Controlling in Section | S _____ T _____ R _____ | |
| | S _____ T _____ R _____ | |
| 3. Miscellaneous Property in Sec. | S _____ T _____ R _____ | |
| | S _____ T _____ R _____ | |

Register of Deeds Stamp & File Number

4. Lot No. _____, Recorded Plat _____
5. Private Claims _____

	A	B	C	D	E	F	G	H	I	J	K	L	M
2	6	5	4	3	2	1							
3													
4	7	8	9	10	11	12							
5													
6	18	17	16	15	14	13							
7													
8	19	20	21	22	23	24							
9													
10	30	29	28	27	26	25							
11													
12	31	32	33	34	35	36							
13													

I, Randal J. Vugteveen, in a field survey on December 8, 19 94, do hereby certify that under requirements of P.A. 74, Michigan P.A. of 1970, the corner points mentioned in lines 1 and 2 above were in conformance with regulations and rules therefore as required in the current manual of survey instructions of the United States Department of the Interior, Bureau of Land Management or by a decree of a Court of Law and/or that the corner points mentioned in lines 3, 4 and 5 above were in conformance with the rules of the Michigan Board of Land Surveyors or by a Decree of a Court of Law, established, re-established, monumented, re-monumented, recovered, found as expressed below:

NOTE: Not more than 4 corners, all in the same town and range, may be recorded on this certificate.

A. Description of original monument and accessories and/or subsequent restoration:
F-7 Common corner to Sections 16 & 21

1832 - Brookfield	Liber 2, Page 221	Liber 1, Page 259
Set post	Found iron bar in monument box	Found iron in mon box
Pine 4" N60E 99 Links	Conc. R/W marker SE 70.54'	
Pine 4" S78W 1.87 Chains	Support pole NW 92.67'	
	P. pole SW 64.12'	
	Cross on S' end of culvert SW 22.93'	

B. Description of corner evidence found and/or method applied in restoring or reestablishing corner:

F-7 Found CIM in mon box on centerline James St. 153' E of centerline US-31 and accepted as a careful and faithful perpetuation of the position of the original corner
NE 42.03' MDSH nail & tag in SE side P. pole
SE 76.13' MDSH nail & tag in N. side P. pole
SW 87.57' PK nail in NW side of guy pole

P.A. 345 OTTAWA COUNTY
PEER APPROVED 12/12/94


Melroy D. Nedwell

C. Description of monument for corner and accessories established to perpetuate locating the position of the corner:

F-7 Cast Iron Monument

AZ = Michigan State Grid Direction

Set Ottawa County Remon Tag & Nail in SE side P. pole AZ. 40 deg 42.03'
Set Ottawa County Remon Tag & Nail in SE side P. pole AZ. 230 deg 63.98'
Set Ottawa County Remon Tag & Nail in SW side P. pole AZ. 121 deg 76.16'
Set Ottawa County Remon Tag & Nail in SW side guide pole AZ. 308 deg 135.22'

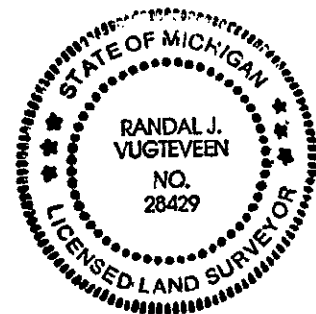

Signed by

Randal J. Vugteveen

Date

Dec 12, 1994

Surveyor's Michigan License No.

28429

FORM APPROVED BY MICHIGAN STATE BOARD OF LAND SURVEYORS, JAN. 26, 1971
REVISED MAY 14, 1975
REVISED JAN., 1983