

**OTTAWA COUNTY REMONUMENTATION
LAND CORNER RECORDATION CERTIFICATE**
Filing Requirement of Act 74, Mich. P.A. 1970

For corners in <u>Ottawa</u> <small>(County)</small>	Located In:	Corner Code #
1. Public Land Survey	T5N R15W	F-9
	T R	N 1/4 cor. Sec. 28
	T R	Holland Twp.
	T R	
2. Property Controlling in Section	S T R	
	S T R	
3. Miscellaneous Property in Sec.	S T R	
	S T R	
4. Lot No. _____, Recorded Plat _____		
5. Private Claims _____		

RECORDED
96 DEC 20 PM 12: 21
Richard R. Kautzman
REGISTER OF DEEDS
OTTAWA COUNTY, MI
Register of Deeds Stamp & File Number

I, Steven Lampen, in a field survey on December 9, 1996, do hereby certify that under requirements of P.A. 74, Michigan P.A. of 1970, the corner points mentioned in lines 1 and 2 above were in conformance with regulations and rules therefore as required in the current manual of survey instructions of the United States Department of the Interior, Bureau of Land Management or by a decree of a Court of Law and/or that the corner points mentioned in lines 3, 4 and 5 above were in conformance with the rules of the Michigan Board of Land Surveyors or by a Decree of a Court of Law; established, re-established, monumented, re-monumented, recovered, found as expressed below:

1	A	B	C	D	E	F	G	H	I	J	K	L	M
2	6	5	4	3	2	1							
3													
4	7	8	9	10	11	12							
5													
6	18	17	16	15	14	13							
7													
8	19	20	21	22	23	24							
9													
10	30	29	28	27	26	25							
11													
12	31	32	33	34	35	36							
13													

NOTE: Not more than 4 corners, all in the same town and range, may be recorded on this certificate.


A. Description of original monument and accessories and/or subsequent restoration:
F-9
GLO - Brookfield - 1832
1/4 Section post on true line
White Ash 10 N 15 W 26'
do 10 S 25 E 25
F-9 Not recorded

The North and South 1/4 line of Section 28 is shown on the Plats of Village of Cedar Swamp - 1848 and Riverside Addition - 1892

B. Description of corner evidence found and/or method applied in restoring or reestablishing corner:
F-9
Re-establish the position of F-9 by using the found monumentation along the North and South 1/4 line of Section 28 per the Plats of Village of Cedar Swamp and Riverside Addition and also survey information from Williams and Works - 1955 for East and West location. Used a straight line between E-9 and G-9 for the North and South location. Set Ottawa County Remonumentation iron and cap and is accepted as a careful and faithful re-establishment of the position of the original corner.

P.A. 345 OTTAWA COUNTY
PEER APPROVED 12-9-96
M.D.M.

C. Description of monument for corner and accessories established to perpetuate locating the position of the corner:
F-9
Ottawa County Remonumentation iron and cap. Azimuth = compass
South bank of the Macatawa River 0° 59'
Remon. tag North side 14" Ash 83° 53.19'
Remon. tag East side 6" Ash 315° 26.02'
Remon. tag SE'ly side, SE'ly tree of quad 12" Ash 38° 79.69'

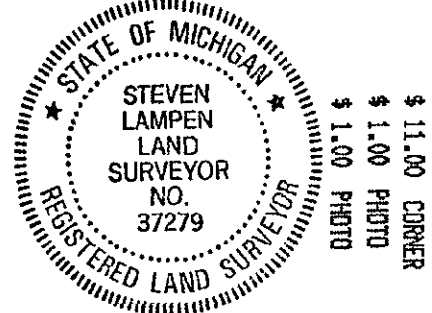

Signed by Steven Lampen Date DECEMBER 13, 1996
Surveyor's Michigan License No. 37279

