

**SURVEY & REMONUMENTATION**

APR 05 1996

OTTAWA COUNTY REMONUMENTATION

COMMISSION

LAND CORNER RECORDATION CERTIFICATE  
Filing Requirement of Act 74, Mich. P.A. 1970

For corners in  
OTTAWA  
(County)

Located In: Corner Code #

- |                                       |                          |  |
|---------------------------------------|--------------------------|--|
| 1. Public Land Survey                 | T <u>5N</u> R <u>15W</u> | F-11 (S 1/4<br>corner Section<br>28) Holland<br>Twp. |
|                                       | T _____ R _____          |  |
|                                       | T _____ R _____          |  |
|                                       | T _____ R _____          |  |
| 2. Property Controlling<br>in Section | S _____ T _____ R _____  |  |
|                                       | S _____ T _____ R _____  |  |
| 3. Miscellaneous<br>Property in Sec.  | S _____ T _____ R _____  |  |
|                                       | S _____ T _____ R _____  |  |

RECORDED

95 NOV 15 PM 2:12

*Rhodes Kullman*  
REGISTER OF DEEDS  
OTTAWA COUNTY, MI

Register of Deeds Stamp & File Number

4. Lot No. \_\_\_\_\_, Recorded Plat \_\_\_\_\_  
5. Private Claims \_\_\_\_\_

I, Randal J. Vugteveen, in a field survey on October 17, 19 95, do hereby certify that under requirements of P.A. 74, Michigan P.A. of 1970, the corner points mentioned in lines 1 and 2 above were in conformance with regulations and rules therefore as required in the current manual of survey instructions of the United States Department of the Interior, Bureau of Land Management or by a decree of a Court of Law and/or that the corner points mentioned in lines 3, 4 and 5 above were in conformance with the rules of the Michigan Board of Land Surveyors or by a Decree of a Court of Law; established, re-established, monumented, re-monumented, recovered, found as expressed below:

A	B	C	D	E	F	G	H	I	J	K	L
2	6	5	4	3	2	1					
3											
4	7	8	9	10	11	12					
5											
6	18	17	16	15	14	13					
7											
8	19	20	21	22	23	24					
9											
10	30	29	28	27	26	25					
11											
12	31	32	33	34	35	36					
13											

**NOTE: Not more than 4 corners, all in the same town and range, may be recorded on this certificate.**

A. Description of original monument and accessories and/or subsequent restoration:  
F-11 Common corner to Sections 28 & 33

1830 - Lyon	Liber 2, Page 795	Liber 2, Page 111
Set 1/4 Section post	Brass Plug	SE corner pillar N22W 41.63'
Beech N59 W39 20 Links	N. corner fence SSE 34.5'	SW corner pillar N 37.05'
Beech S5 W33 18 Links	30" Maple NNW 40.0'	CP pole S70W 74.18'
	30" Pine SSW 40.6'	
	24" Maple NNE 48.8'	

B. Description of corner evidence found and/or method applied in restoring or reestablishing corner:


F-11 Found brass plug 3.8' N of centerline E 16th St. in mon box (no cover) and accepted as a careful and faithful perpetuation of the position of the original corner  
30" Maple NNW 40.0' CP pole S70W 74.05'  
24" Maple NNE 49.0'

P.A. 345 OTTAWA COUNTY  
PEER APPROVED 10/23/95  
*Randal J. Vugteveen*  
*J.D.M.*

C. Description of monument for corner and accessories established to perpetuate locating the position of the corner:

F-11 Removed brass plug, set 3/4" X 24" solid bar with Ottawa County Remon cap in mon box

NW corner brick building #456 Az. 170 deg 117.90'  
Set Ottawa County Remon Nail & Tag in W side 30" Maple Az. 25 deg 49.17'  
Set Ottawa County Remon Nail & Tag in E side 30" Maple Az. 325 deg 40.18'  
Set Ottawa County Remon Nail & Tag in SE side p. pole Az. 250 deg 74.05'

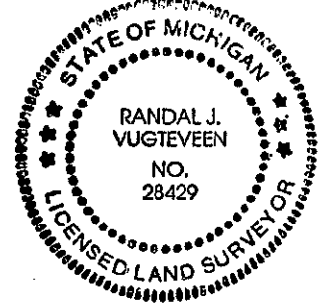

Signed by *Randal J. Vugteveen*  
Surveyor's Michigan License No. 28429

Date Oct. 20, 1995