

SURVEY & REMONUMENTATION

APR 05 1996

COMMISSION

OTTAWA COUNTY REMONUMENTATION

LAND CORNER RECORDATION CERTIFICATE
Filing Requirement of Act 74, Mich. P.A. 1970

For corners in
OTTAWA
(County)

	Located In:	Corner Code #
1. Public Land Survey	5N 15W	F-13 (S 1/4 cor Section 33) Holland Twp.
	T R	
	T R	
	T R	
2. Property Controlling in Section	S T R	
	S T R	
3. Miscellaneous Property in Sec.	S T R	
	S T R	

RECORDED

95 NOV 15 PM 2:12

Rhonda Holloman
REGISTER OF DEEDS
OTTAWA COUNTY, MI

Register of Deeds Stamp & File Number

4. Lot No. _____, Recorded Plat _____
5. Private Claims _____

	A	B	C	D	E	F	G	H	I	J	K	L
2	6	5	4	3	2	1						
3												
4	7	8	9	10	11	12						
5												
6	18	17	16	15	14	13						
7												
8	19	20	21	22	23	24						
9												
10	30	29	28	27	26	25						
11												
12	31	32	33	34	35	36						
13												

I, Randal J. Vugteveen, in a field survey on October 19, 19 95, do hereby certify that under requirements of P.A. 74, Michigan P.A. of 1970, the corner points mentioned in lines 1 and 2 above were in conformance with regulations and rules therefore as required in the current manual of survey instructions of the United States Department of the Interior, Bureau of Land Management or by a decree of a Court of Law and/or that the corner points mentioned in lines 3, 4 and 5 above were in conformance with the rules of the Michigan Board of Land Surveyors or by a Decree of a Court of Law; established, re-established, monumented, re-monumented, recovered, found as expressed below:

NOTE: Not more than 4 corners, all in the same town and range, may be recorded on this certificate.

A. Description of original monument and accessories and/or subsequent restoration:
F-13 Common corner to Section 33

1832 - Lyon	Liber 3, Page 5	Liber 2, Page 509
Set HMP	PK nail on P. pole WNW 56.31'	Boat Spike
W. Oak N57 1/2 E32 20 Links	Nail in 30" Oak N 38.34'	Trans pole NW 55.70'
Maple N43 W39 22 Links	PK nail on P. pole ENE 93.51'	P. pole ENE 92.90'
	Iron @ 71.94'	18" Ash NNW 38.30'
		Iron pipe W 71.90'


B. Description of corner evidence found and/or method applied in restoring or reestablishing corner:
F-13 Found OCRM cap in mon box on centerline E 32nd St. & 33' W of centerline Hastings Ave N and accepted as a careful and faithful perpetuation of the position of the original corner

PK nail on P. pole WNW 56.31'	Boat Spike
Nail in 30" Oak N 38.34'	Trans pole NW 55.70'
PK nail on P. pole ENE 93.51'	P. pole ENE 92.90'
Iron @ 71.94'	18" Ash NNW 38.30'
	Iron pipe W 71.90'

P.A. 345 OTTAWA COUNTY
PEER APPROVED 10/23/95
Randy P. Hedwold
RDY

C. Description of monument for corner and accessories established to perpetuate locating the position of the corner:
F-13 Cast Iron Monument in mon box

- Set Ottawa County Remon Nail & Tag in N side p. pole Az. 71 deg 97.65'
- ACRM cap in mon box Az. 270 deg 71.92'
- NE corner building #442 Az. 224 deg 136.06'
- Chisled "X" in N side concrete light base Az. 201 deg 90.44'
- Set Ottawa County Remon Nail & Tag in S side guide pole Az. 112 deg 96.17'
- Found Ottawa County Remon Nail & Tag in S side p. pole Az. 279 deg 192.48'
- Set Ottawa County Remon Nail & Tag in SE side p. pole Az. 302 deg 59.05'

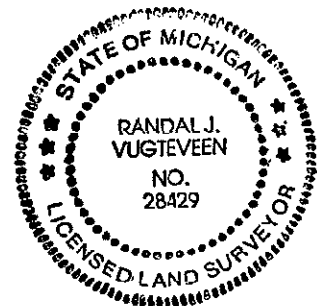

Signed by *Randal J. Vugteveen*
Surveyor's Michigan License No. 28429

Date OCT. 20, 1995