

**SURVEY & REMONUMENTATION**

DEC 01 1998

SECTION

Ottawa County Remonumentation  
**LAND CORNER RECORDATION CERTIFICATE**  
 Filing Requirement of Act 74, Mich. P.A. 1970

RECORDED

98 MAY 22 PM 4:06

*Sam Schell*  
 REGISTER OF DEEDS  
 OTTAWA COUNTY, MI

For corners in

<u>Ottawa</u> (County)	Located In:	Corner Code #
1. Public Land Survey	T <u>5N</u> R <u>15W</u>	G-1 (NW, 3) <u>Holland Twp.</u>
	T _____ R _____	_____
	T _____ R _____	_____
2. Property Controlling in Section	S _____ T _____ R _____	_____
	S _____ T _____ R _____	_____
3. Miscellaneous Property in Sec.	S _____ T _____ R _____	_____
	S _____ T _____ R _____	_____

Register of Deeds Stamp & File Number

4. Lot No. \_\_\_\_\_, Recorded Plat \_\_\_\_\_  
 5. Private Claims \_\_\_\_\_

	A	B	C	D	E	F	G	H	I	J	K	L	M
2	6	5	4	3	2	1							
3													
4	7	8	9	10	11	12							
5													
6	18	17	16	15	14	13							
7													
8	19	20	21	22	23	24							
9													
10	30	29	28	27	26	25							
11													
12	31	32	33	34	35	36							
13													

I, John C. Bueche, in a field survey on March 19, 19 98, do hereby certify that under requirements of P.A. 74, Michigan P.A. of 1970, the corner points mentioned in lines 1 and 2 above were in conformance with regulations and rules therefore as required in the current manual of survey instructions of the United States Department of the Interior, Bureau of Land Management or by a decree of a Court of Law and/or that the corner points mentioned in lines 3, 4 and 5 above were in conformance with the rules of the Michigan Board of Land Surveyors or by a Decree of a Court of Law; established, re-established, monumented, re-monumented, recovered, found as expressed below:

**NOTE: Not more than 4 corners, all in the same town and range, may be recorded on this certificate.**

A. Description of original monument and accessories and/or subsequent restoration:

G-1 GLO Lucius Lyon, 1831 North boundary 78 East of post, set cor. secs. 3 & 4	LCRC L1, P253, Feb., 1972 Fnd. angle iron Nail in face of TP SW 55.90' NE cor. hdwl. SE 23.10'	LCRC L1, P397, May, 1972 Set PK from ties PP SE 47.48' C/L hydt. SE 45.48' St. sign NNW 21.42' SW hse. cor. NE 100.37' Olive Twp. cor. W 51.70'
--	---	---

B. Description of corner evidence found and/or method applied in restoring or reestablishing corner:

G-1 Found 2" Harrison Mon. in Mon. Box, 0.42' South of Township line G-13 (SE 33) & H-13 (S 1/4 34) 6-15, on C/L bit. road E-W, on bit. road South extended North  
 PP SE 47.48'±  
 C/L hydt. SE 48.44' Meas.  
 SW hse. cor. NE 100.37'±  
 Olive Twp. cor. W 51.70'


And is accepted as a careful and faithful perpetuation of the position of the original corner.

PA. 343 OTTAWA COUNTY

PEER APPROVED 4/20/98

C. Description of monument for corner and accessories established to perpetuate locating the position of the corner:

G-1 Set conc. Nail & Ottawa Co. Remon. Tag on Township Line on North edge of Mon. Box  
 SW cor. fnd. to hse. N 10° E 99.94'  
 SE cor. fnd. to hse. N 27° E 110.55'  
 Ottawa Co. Remon. Tag & Nail in NE side PP S 58° E 51.15'  
 Ottawa Co. Remon. Tag & Nail in NE side GP N 75° W 96.32'  
 Ottawa Co. Remon. Tag & Nail in N side PP S 80° E 167.77'  
 Set PK North 1.03' & West 1.00'  
 On C/L bit. road N-S, on C/L bit. road South extended North  
 Ottawa Co. Mon. in Mon. Box West 51.69' G-13 (SE 33, 6-15)

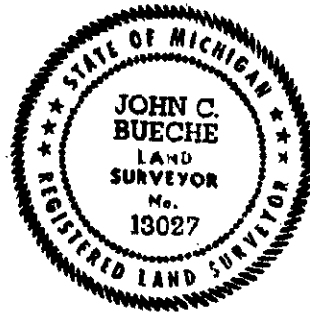

4 11.00 CORNER  
 4 2.00 PHOTO

Signed by John C. Bueche, P.S. 13027 Date 4-1-98

Surveyor's Michigan License No. 13027

SURVEY &  
REMONUMENTATION

DEC 01 1998

SECTION

