

SURVEY & REMONUMENTATION

DEC 01 1993

COMMISSION

OTTAWA COUNTY REMONUMENTATION

LAND CORNER RECORDATION CERTIFICATE
Filing Requirement of Act 74, Mich. P.A. 1970

RECORDED

93 NOV 11 AM 11: 54

Ralph J. Vugteveen
REGISTER OF DEEDS
OTTAWA COUNTY, MI

For corners in OTTAWA

(County)

Located In:

Corner Code #

1. Public Land Survey	T	5N	R	15W	G-3 (NE	cor
	T		R		Section 9)	
	T		R		Holland Twp	
	T		R			
	T		R			
2. Property Controlling in Section	S		T	R		
	S		T	R		
3. Miscellaneous Property in Sec.	S		T	R		
	S		T	R		

Register of Deeds Stamp & File Number

4. Lot No. _____, Recorded Plat _____
5. Private Claims _____

	A	B	C	D	E	F	G	H	I	J	K	L	M
2	6		5		4		3		2		1		
3							●						
4	7		8		9		10		11		12		
5													
6	18		17		16		15		14		13		
7													
8	19		20		21		22		23		24		
9													
10	30		29		28		27		26		25		
11													
12	31		32		33		34		35		36		
13													

I, Randal J. Vugteveen, in a field survey on August 12, 1993, do hereby certify that under requirements of P.A. 74, Michigan P.A. of 1970, the corner points mentioned in lines 1 and 2 above were in conformance with regulations and rules therefore as required in the current manual of survey instructions of the United States Department of the Interior, Bureau of Land Management or by a decree of a Court of Law and/or that the corner points mentioned in lines 3, 4 and 5 above were in conformance with the rules of the Michigan Board of Land Surveyors or by a Decree of a Court of Law; established, re-established, monumented, re-monumented, recovered, found as expressed below:

NOTE: Not more than 4 corners, all in the same town and range, may be recorded on this certificate.

A. Description of original monument and accessories and/or subsequent restoration:
G-3 Common corner to Sections 3, 4, 9 & 10


LCRC Liber 1, Page 583	LCRC Liber 1, Page 553
1/2" pipe in mon box	Pinch pipe in mon box
P. Pole SW 60.71'	P. Pole SW 60.86'
P. Pole NE 56.10'	P. Pole NE 56.20'
SE cor N wingwall, E	
Howl S-SE 73.15'	

B. Description of corner evidence found and/or method applied in restoring or reestablishing corner:
G-3 Found 3/4" pinched iron in mon box at centerline "X" of Quincy & 120th and accepted as a careful and faithful perpetuation of the position of the original corner

Nail & bottle cap in W side P. Pole N62E 56.03'	PK in N side P. Pole S65W 61.19'
---	----------------------------------

C. Description of monument for corner and accessories established to perpetuate locating the position of the corner:
G-3 Set Ottawa County Remon Cap on 36" X 3/4" solid rod cemented in mon box flush with pavement

- Set Ottawa County Remon Tag & Nail in N side P. Pole S65W 61.35'
- Set Ottawa County Remon Tag & nail in E side Guy Pole S10W 181.81'
- Set Ottawa County Remon Tag & Nail in S side P. Pole N62E 56.61'
- Set Ottawa County Remon Tags & Nails N, S, E & W 50.00'

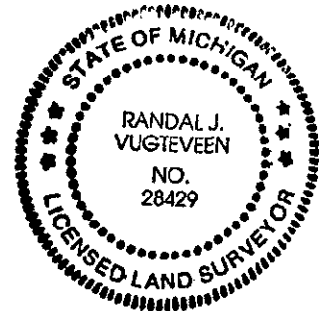

Signed by *Randal J. Vugteveen* Date Nov 5, 1993
Surveyor's Michigan License No. 28429