

DEC 01 1993

OTTAWA COUNTY REMONUMENTATION

COMMISSION

LAND CORNER RECORDATION CERTIFICATE
Filing Requirement of Act 74, Mich. P.A. 1970

RECORDED

93 NOV 11 AM 11:54

For corners in OTTAWA
(County)

Located In:	Corner Code #
T <u>5N</u> R <u>15W</u>	G-4 (W 1/4 cor
T _____ R _____	Section 10)
T _____ R _____	Holland Twp
T _____ R _____	_____
S _____ T _____ R _____	_____
S _____ T _____ R _____	_____
S _____ T _____ R _____	_____
S _____ T _____ R _____	_____

Rhonda Kallman
REGISTER OF DEEDS
OTTAWA COUNTY, MI

Register of Deeds Stamp & File Number

- 4. Lot No. _____, Recorded Plat _____
- 5. Private Claims _____

	A	B	C	D	E	F	G	H	I	J	K	L	M
2	6	5	4	3	2	1							
3													
4	7	8	9	10	11	12							
5													
6	18	17	16	15	14	13							
7													
8	19	20	21	22	23	24							
9													
10	30	29	28	27	26	25							
11													
12	31	32	33	34	35	36							
13													

I, Randal J. Vugteveen, in a field survey on August 12, 1993, do hereby certify that under requirements of P.A. 74, Michigan P.A. of 1970, the corner points mentioned in lines 1 and 2 above were in conformance with regulations and rules therefore as required in the current manual of survey instructions of the United States Department of the Interior, Bureau of Land Management or by a decree of a Court of Law and/or that the corner points mentioned in lines 3, 4 and 5 above were in conformance with the rules of the Michigan Board of Land Surveyors or by a Decree of a Court of Law; established, re-established, monumented, re-monumented, recovered, found as expressed below:

NOTE: Not more than 4 corners, all in the same town and range, may be recorded on this certificate.

A. Description of original monument and accessories and/or subsequent restoration:
G-4 Common 1/4 corner to Sections 9 & 10


LCRC Liber 1, Page 273	LCRC Liber 1, Page 553
Nail in face of 24" Sycamore NE 120.73' /	3/4" Pipe
Nail in face of P. Pole SE 25.74' / Nail	P. Pole SE 26.28'
in face of T. Pole SW 68.32' / Street sign	T. Pole SW 66.80'
SW 68.57' / Centerline pmt 120th Ave W	NE cor headwall SW 12.4'
33.35'	SE cor headwall NW 12.5'

B. Description of corner evidence found and/or method applied in restoring or reestablishing corner:
G-4 Found capped iron 32.5' E of centerline 120th & 2' No. of centerline Greenly and accpeted as a careful perpetuation of the position of the original corner

Nail & Tag in W side Sycamore N60E 120.74'	
--	--

C. Description of monument for corner and accessories established to perpetuate locating the position of the corner:
G-4 Set Ottawa County Remon Cap on 24" X 3/4" solid rod in pavement

- Set Ottawa County Remon Tag & Nail in SE side P. Pole S57W 81.62'
- Set Ottawa County Remon Tag & Nail in E side P. Pole S29E 39.97'
- Set Ottawa County Remon Tag & Nail in S side 24" Sycamore N61E 121.97'
- Set Ottawa County Remon Tag & Nail in N side 10" Ash N47E 79.79'

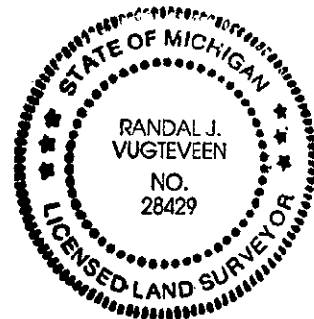

Signed by *Randal J. Vugteveen* Date Nov 5, 1993

Surveyor's Michigan License No. 28429