

DEC 01 1993

OTTAWA COUNTY REMONUMENTATION

RECORDED

93 NOV 11 AM 11:56

COMMISSION

LAND CORNER RECORDATION CERTIFICATE
Filing Requirement of Act 74, Mich. P.A. 1970

D. J. ...
REGISTER OF DEEDS
OTTAWA COUNTY, MI

For corners in OTTAWA

(County)

Located in:


Corner Code #

1. Public Land Survey	T	<u>5N</u>	R	<u>15W</u>	G-5 (NE	COR
	T		R		Section 16)	
	T		R		Holland Twp	
	T		R			
2. Property Controlling in Section	S		T	R		
	S		T	R		
3. Miscellaneous Property in Sec.	S		T	R		
	S		T	R		

Register of Deeds Stamp & File Number

4. Lot No. _____, Recorded Plat _____
5. Private Claims _____

I, Randal J. Vugteveen, in a field survey on August 12, 19 93, do hereby certify that under requirements of P.A. 74, Michigan P.A. of 1970, the corner points mentioned in lines 1 and 2 above were in conformance with regulations and rules therefore as required in the current manual of survey instructions of the United States Department of the Interior, Bureau of Land Management or by a decree of a Court of Law and/or that the corner points mentioned in lines 3, 4 and 5 above were in conformance with the rules of the Michigan Board of Land Surveyors or by a Decree of a Court of Law; established, re-established, monumented, re-monumented, recovered, found as expressed below:

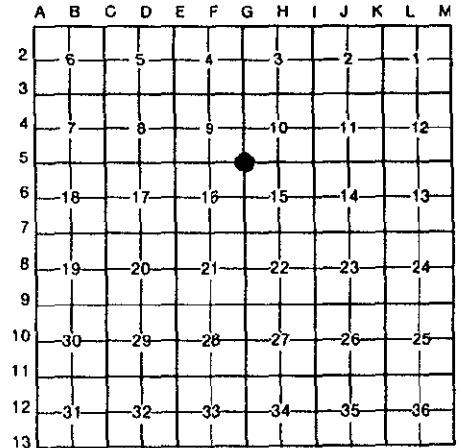

NOTE: Not more than 4 corners, all in the same town and range, may be recorded on this certificate.

A. Description of original monument and accessories and/or subsequent restoration:
G-5 Common corner to Sections 9, 10, 15 & 16


LCRC Liber 1, Page 259	LCRC Liber 1, Page 555	LCRC Liber 5, Page 138
Iron in concrete mon / SW cor culvert wall	Pinch pipe in mon box	Cast Iron Mon
NE 23.9' / NW cor culvert wall SE 29.6' /	T. Pole NW 43.05'	Guy Pole NW 43.13'
Nail in face of T. Pole NW 43.6' / Nail in	G. Pole SE 35.53'	Cen St. sign SW 47.19'
face of P. Pole SE 89.0'	Cor headwall &	T. Pole S-SW 128.14'
	wingwall E-NE 24'	P. Pole SE 35.62'

B. Description of corner evidence found and/or method applied in restoring or reestablishing corner:
G-5 Found cast iron monument in mon box 3' East of centerline 120th & 0.8' North centerline Riley and accepted as a careful and faithful perpetuation of the position of the original corner

Center of St. Sign S55W 47.21'

C. Description of monument for corner and accessories established to perpetuate locating the position of the corner:
G-5 Set Ottawa County Remon Cap on top of monument cemented in mon box

- Set Ottawa County Remon Tag & Nail in SE side P. Pole N47E 55.86'
- Set Ottawa County Remon Tag & Nail in E side P. Pole S27W 76.13'
- SW corner of 24" X 24" Brick pier N35E 88.65'
- SW corner of 24" X 24" Brick pier N63E 90.85'

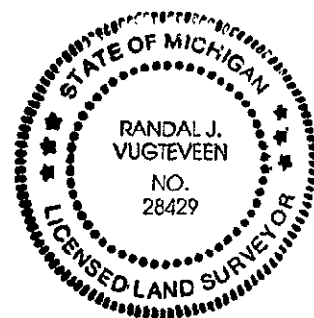

Signed by Randal J. Vugteveen Date 11/5/93
Surveyor's Michigan License No. 28429