

DEC 01 1993

LAND CORNER RECORDATION CERTIFICATE

93 NOV 11 AM 11:54

Filing Requirement of Act 74, Mich. P.A. 1970

REGISTER OF DEEDS OTTAWA COUNTY, MI

For corners in COMMISSION

Located In: Corner Code #/ 1. Public Land Survey T 5N R 15W G-6 (W 1/4 cor Section 15) Holland Twp

Register of Deeds Stamp & File Number

4. Lot No. , Recorded Plat 5. Private Claims

Grid table with columns A-M and rows 2-13, showing section numbers 1-36.

I, Randal J. Vugteveen, in a field survey on September 3, 1993, do hereby certify that under requirements of P.A. 74, Michigan P.A. of 1970, the corner points mentioned in lines 1 and 2 above were in conformance with regulations and rules therefore as required in the current manual of survey instructions of the United States Department of the Interior, Bureau of Land Management or by a decree of a Court of Law and/or that the corner points mentioned in lines 3, 4 and 5 above were in conformance with the rules of the Michigan Board of Land Surveyors or by a Decree of a Court of Law; established, re-established, monumented, re-monumented, recovered, found as expressed below:

NOTE: Not more than 4 corners, all in the same town and range, may be recorded on this certificate.

A. Description of original monument and accessories and/or subsequent restoration:


G-6 1/4 corner common to Sections 15 & 16 LCRC Liber 1, Page 259 | LCRC Liber 6, Page 235 Angle Iron in mon box / Nail in face of T. Pole SW 38.80' / Nail in face of fence post face SE 46.70' / St. Sign NE 28.39' | PK E side P. Pole S15W 62.43' / PK in face of gutter pan. N65W 50.69' / 16-D W side T. Pole N30W 115.99' / Found R.L.S. cap W side 14" M. N35E 103.85' / Found R.L.S. cap S side 10" Ash N50E 56.07' / 16-D N side 30" Oak S65E 99.87' / On CL. N-S & W Bit. Roads

B. Description of corner evidence found and/or method applied in restoring or reestablishing corner:

G-6 Found cast iron monument in mon box 0.5' E of centerline 120th and on centerline Felch St. and accepted as a careful and faithful perpetuation of the position of the original corner PK E side P. Pole S15W 62.43' Found R.L.S. Cap S side 10" Ash N50E 56.07'

C. Description of monument for corner and accessories established to perpetuate locating the position of the corner:

G-6 Set Ottawa County Remon Cap in concrete in mon box Set Ottawa County Remon Tag & Nail in S side L. Pole E 37.08' Set Ottawa County Remon Tag & Nail in N side 24" Oak S80E 100.04' Set Ottawa County Remon Tag & Nail in W side 14" Maple N19E 103.83' Set Ottawa County Remon Tag & Nail E side P. Pole N11W 157.76' Set Ottawa County Remon Tag & Nail in E side P. Pole S30W 62.43'

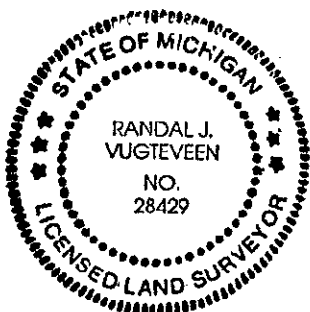

Signed by [Signature] Date Nov 5, 1993 Surveyor's Michigan License No. 28429