

SURVEY & REMONUMENTATION

APR 24 1995

OTTAWA COUNTY REMONUMENTATION

RECORDED

LAND CORNER RECORDATION CERTIFICATE
Filing Requirement of Act 74, Mich. P.A. 1970

94 DEC 11 AM 9:43

COMMISSION
For corners in
OTTAWA
(County)

Richard R. Ballman
REGISTER OF DEEDS
OTTAWA COUNTY, MI

	Located In:	Corner Code #
1. Public Land Survey	<u>T5N R15W</u>	<u>G-8 (E 1/4 cor Section 21)</u> <u>Holland Twp.</u>
2. Property Controlling in Section	S ___ T ___ R ___	___
3. Miscellaneous Property in Sec.	S ___ T ___ R ___	___

Register of Deeds Stamp & File Number

4. Lot No. _____, Recorded Plat _____
5. Private Claims _____

	A	B	C	D	E	F	G	H	I	J	K	L	M
2	6	5	4	3	2	1							
3													
4	7	8	9	10	11	12							
5													
6	18	17	16	15	14	13							
7													
8	19	20	21	22	23	24							
9													
10	30	29	28	27	26	25							
11													
12	31	32	33	34	35	36							

I, Randal J. Vugteveen, in a field survey on December 8, 19 94, do hereby certify that under requirements of P.A. 74, Michigan P.A. of 1970, the corner points mentioned in lines 1 and 2 above were in conformance with regulations and rules therefore as required in the current manual of survey instructions of the United States Department of the Interior, Bureau of Land Management or by a decree of a Court of Law and/or that the corner points mentioned in lines 3, 4 and 5 above were in conformance with the rules of the Michigan Board of Land Surveyors or by a Decree of a Court of Law, established, re-established, monumented, re-monumented, recovered, found as expressed below.

NOTE: Not more than 4 corners, all in the same town and range, may be recorded on this certificate.

A. Description of original monument and accessories and/or subsequent restoration:
G-8 Common corner to Sections 21 & 22

1832 - Brookfield	Liber 1, Page 579	Liber 5, Page 19
Set post	Found bolt	Replaced with cast monument
Lynn 10" is post	Nail in face of Light pole SW 42.78'	SE 54.70' PK in SW side LP
	Nail in face of T. pole WNW 110.50'	WNW 111.06' PK in N side PP
	Nail in face of 30" Maple ENE 111.24'	SW 60.54' PK in W side TP
	Nail in face of T. pole NNW 100.71'	NE 49.03' C/L top hydrant
		NNW 100.89' PK in W side TP

B. Description of corner evidence found and/or method applied in restoring or reestablishing corner:
G-8 Found CIM in mon box at centerline "x" on 120th Ave & Lakewood Blvd. and accepted as a careful and faithful perpetuation of the position of the original corner

Nail in face of T. pole WNW 110.5'	WNW 111.00' PK in N side P. pole
	SW 60.5' PK in W side T. pole


P.A. 345 OTTAWA COUNTY
PEER APPROVED 12/12/94

Randal J. Vugteveen

C. Description of monument for corner and accessories established to perpetuate locating the position of the corner:

G-8 Cast Iron Monument in mon box
AZ = Michigan State Grid Direction

Set Ottawa County Remon Tag & Nail in SW side L. pole AZ. 138 deg 50.00'
Set Ottawa County Remon Tag & Nail in SE side P. pole AZ. 207 deg 60.63'
Set Ottawa County Remon Tag & Nail in SW side P. pole AZ. 317 deg 65.30'
Top hydrant AZ. 50 deg 53.54'

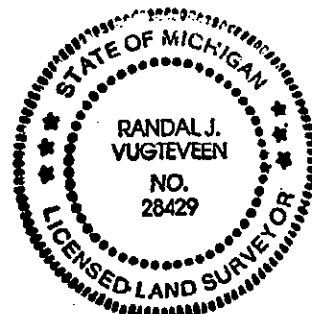

Signed by Randal J. Vugteveen
Surveyor's Michigan License No. 28429

Date Dec 12, 1994