

SURVEY & REMONUMENTATION

APR 24 1995

COMMISSION

OTTAWA COUNTY REMONUMENTATION

LAND CORNER RECORDATION CERTIFICATE
Filing Requirement of Act 74, Mich. P.A. 1970

RECORDED

94 DEC 14 AM 9:41

For corners in
OTTAWA
(County)

Located In: Corner Code ##

- | | | |
|---------------------------------------|-------------------------|---|
| 1. Public Land Survey | <u>5N</u> <u>R15W</u> | <u>G-9 (SE cor</u>
<u>Section 21)</u>
<u>Holland Twp.</u> |
| | T _____ R _____ | |
| | T _____ R _____ | |
| | T _____ R _____ | |
| 2. Property Controlling in Section | S _____ T _____ R _____ | |
| | S _____ T _____ R _____ | |
| 3. Miscellaneous Property in Sec. | S _____ T _____ R _____ | |
| | S _____ T _____ R _____ | |
| 4. Lot No. _____, Recorded Plat _____ | | |
| 5. Private Claims _____ | | |

Phyllis Holman
REGISTER OF DEEDS
OTTAWA COUNTY, MI

Register of Deeds Stamp & File Number

I, Randal J. Vugteveen, in a field survey on December 8, 19 94, do hereby certify that under requirements of P.A. 74, Michigan P.A. of 1970, the corner points mentioned in lines 1 and 2 above were in conformance with regulations and rules therefore as required in the current manual of survey instructions of the United States Department of the Interior, Bureau of Land Management or by a decree of a Court of Law and/or that the corner points mentioned in lines 3, 4 and 5 above were in conformance with the rules of the Michigan Board of Land Surveyors or by a Decree of a Court of Law; established, re-established, monumented, re-monumented, recovered, found as expressed below:

NOTE: Not more than 4 corners, all in the same town and range, may be recorded on this certificate.

A	B	C	D	E	F	G	H	I	J	K	L	M
2	6	5	4	3	2	1						
3												
4	7	8	9	10	11	12						
5												
6	18	17	16	15	14	13						
7												
8	19	20	21	22	23	24						
9												
10	30	29	28	27	26	25						
11												
12	31	32	33	34	35	36						
13												

A. Description of original monument and accessories and/or subsequent restoration:
G-9 Common corner to Sections 21, 22, 27 & 28

1832 - Brookfield
Set corner
Elm 30" East 13 Links
Hemlock 12" S32W 14 Links

Liber 1, Page 275
Found Monument box

Liber 1, Page 689
Mon box
N line E bound lane M-21 S28E 24.25'
S line W bound lane M-21 N28W 11.88'
E line conc & joint N60E 26.00'
W line conc & joint S60W 28.30'

B. Description of corner evidence found and/or method applied in restoring or reestablishing corner:

G-9 Found "L" iron in mon box on centerline Waverly Rd. between E bound & W bound lanes of Business Loop 196 and accepted as a careful and faithful perpetuation of the position of the original corner
N line E bound lane M-21 S28E 24.30'
Signal light pole N65W 96.32'

P.A. 345 OTTAWA COUNTY
PEER APPROVED 12/12/94


Madison P. Medwell

C. Description of monument for corner and accessories established to perpetuate locating the position of the corner:

G-9 Removed "L" iron, set 3/4" X 36" solid bar with Ottawa County Remon Cap in mon box

AZ = Michigan State Grid Direction

NW corner brick bank AZ. 130 deg 146.13'
Found Ottawa County Remon Tag in NW side P. pole AZ. 205 deg 132.13'
Set Ottawa County Remon Tag & Nail on SW side signal light pole AZ. 287 deg 96.32'
Found Ottawa County Remon Tag & Nail in E side L. pole AZ 333 deg. 80.45'
SW corner wd siding party store AZ. 33 deg 214.14'
Set Ottawa County Remon Tag & Nail in SW side P. & L. pole AZ. 113 deg 99.56'

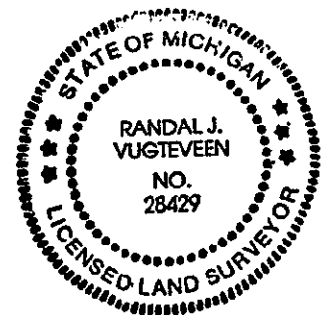

Signed by Randal J. Vugteveen
Surveyor's Michigan License No. 28429

Date Dec 12, 1994