

**SURVEY &
REMONUMENTATION**

APR 05 1996

OTTAWA COUNTY REMONUMENTATION

COMMISSION

LAND CORNER RECORDATION CERTIFICATE

Filing Requirement of Act 74, Mich. P.A. 1970

For corners in
OTTAWA
(County)

	Located In:	Corner Code #
1. Public Land Survey	<u>5N</u> <u>45W</u>	<u>G-13 (SE cor</u> <u>Section 33)</u> <u>Holland Twp.</u>
	T _____ R _____	_____
	T _____ R _____	_____
	T _____ R _____	_____
2. Property Controlling in Section	S _____ T _____ R _____	_____
	S _____ T _____ R _____	_____
3. Miscellaneous Property in Sec.	S _____ T _____ R _____	_____
	S _____ T _____ R _____	_____

RECORDED
95 NOV 29 PM 1:43
D. J. Vugteveen
REGISTER OF DEEDS
OTTAWA COUNTY, MI
Register of Deeds Stamp & File Number

4. Lot No. _____, Recorded Plat _____
5. Private Claims _____

A	B	C	D	E	F	G	H	I	J	K	L	M
2	6	5	4	3	2	1						
3												
4	7	8	9	10	11	12						
5												
6	18	17	16	15	14	13						
7												
8	19	20	21	22	23	24						
9												
10	30	29	28	27	26	25						
11												
12	31	32	33	34	35	36						
13												

I, Randal J. Vugteveen, in a field survey on November 17, 19 95, do hereby certify that under requirements of P.A. 74, Michigan P.A. of 1970, the corner points mentioned in lines 1 and 2 above were in conformance with regulations and rules hereof as required in the current manual of survey instructions of the United States Department of the Interior, Bureau of Land Management or by a decree of a Court of Law and/or that the corner points mentioned in lines 3, 4 and 5 above were in conformance with the rules of the Michigan Board of Land Surveyors or by a Decree of a Court of Law; established, re-established, monumented, re-monumented, recovered, found as expressed below:

NOTE: Not more than 4 corners, all in the same town and range, may be recorded on this certificate.

A. Description of original monument and accessories and/or subsequent restoration:

G-13 Common corner to Sections 33 & 34	Liber	Liber 2, Page 509
1832 - Lyon	Reset re-rod with mon box which was removed by road construction	Found steel bar in mon box
Set post	NE 62.80' to SE cor of C.B. hood	Centerline hydrant NE 53.70'
Lynn N45 E16 8 Links	E 1.86' center of a storm manhole	Centerline St. sign NW 51.29'
Beech N66 1/2 W38 10 Links	SE 78.80' SW corner of CB hood	
	SW 92.60' nail & tag SE side PP	
	W 118.75' to the NW cor of Sec. 3, T4N, R15W	


B. Description of corner evidence found and/or method applied in restoring or reestablishing corner:

G-13 Found HEI Cap in mon box @ centerline "X" E 32nd St. & Waverly Road and accepted as a careful and faithful perpetuation of the position of the original corner
NE 62.78' to SE corner of CB hood
E 1.86' center of a storm manhole
SE 78.75' SW corner of CB hood
Nail & Tag in SE side p. pole SW 92.56'
W 118.72' to the NW cor of Sec. 3, T4N, R15W

PA. 345 OTTAWA COUNTY
PEER APPROVED 11/20/95
K. D. Newell
YDN

C. Description of monument for corner and accessories established to perpetuate locating the position of the corner:

G-13 Removed rebar, set 3/4" solid bar with Ottawa County Remon cap in mon box
Found red cap in mon box Az. 270 deg 118.72' (Allegan Corner)
Set Ottawa County Remon Nail & Tag in SE side p. pole Az. 234 deg 92.56'
Set Ottawa County Remon Nail & Tag in NW side p. pole Az. 47 deg 65.52'
SW corner brick building #761 Az. 58 deg 156.76'
Found Ottawa County Remon Nail & Tag in NE side 12" Maple Az. 320 deg 102.85'

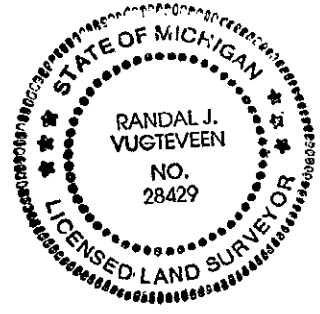

Signed by Randal J. Vugteveen
Surveyor's Michigan License No. 28429

Date Nov. 20, 1995

FORM APPROVED BY MICHIGAN STATE BOARD OF LAND SURVEYORS, JAN. 28, REVISED MAY 14, REVISED JAN.