

**SURVEY &  
REMONUMENTATION**

**OTTAWA COUNTY REMONUMENTATION**

**RECORDED**

**DEC 01 1993**

**LAND CORNER RECORDATION CERTIFICATE  
Filing Requirement of Act 74, Mich. P.A. 1970**

**93 NOV 11 AM 11:54**

*Phyllis Bullman*  
**REGISTER OF DEEDS  
OTTAWA COUNTY, MI**

For corners in **COMMISSION  
OTTAWA**  
(County)

Located In: Corner Code =#

- |                                       |   |    |   |     |   |
|---------------------------------------|---|----|---|-----|---|
| 1. Public Land Survey                 | T | 5N | R | 15W | H-3 (S 1/4 cor<br>Section 3)<br>Holland Twp |
|                                       | T |    | R |     |   |
|                                       | T |    | R |     |   |
|                                       | T |    | R |     |   |
| 2. Property Controlling<br>in Section | S |    | T | R   |   |
|                                       | S |    | T | R   |   |
| 3. Miscellaneous<br>Property in Sec.  | S |    | T | R   |   |
|                                       | S |    | T | R   |   |
4. Lot No. \_\_\_\_\_, Recorded Plat \_\_\_\_\_  
5. Private Claims \_\_\_\_\_

**Register of Deeds Stamp & File Number**

	A	B	C	D	E	F	G	H	I	J	K	L	M
2	6	5	4	3	2	1							
3								●					
4	7	8	9	10	11	12							
5													
6	18	17	16	15	14	13							
7													
8	19	20	21	22	23	24							
9													
10	30	29	28	27	26	25							
11													
12	31	32	33	34	35	36							
13													

I, Randal J. Vugteveen, in a field survey on September 3, 1993, do hereby certify that under requirements of P.A. 74, Michigan P.A. of 1970, the corner points mentioned in lines 1 and 2 above were in conformance with regulations and rules therefore as required in the current manual of survey instructions of the United States Department of the Interior, Bureau of Land Management or by a decree of a Court of Law and/or that the corner points mentioned in lines 3, 4 and 5 above were in conformance with the rules of the Michigan Board of Land Surveyors or by a Decree of a Court of Law; established, re-established, monumented, re-monumented, recovered, found as expressed below:

**NOTE: Not more than 4 corners, all in the same town and range, may be recorded on this certificate.**


A. Description of original monument and accessories and/or subsequent restoration:  
H-3 1/4 corner common to Sections 3 & 10

LCRC Liber 1, Page 583  
Cast Iron Monument  
23" Triple Cherry SE 44.76' / Face of  
Steel Post S-SE 30.74' / 10" Ash E-NE  
42.88'

B. Description of corner evidence found and/or method applied in restoring or reestablishing corner:  
H-3 Found cast iron monument in mon box on centerline Quincy & 15' E of N tree line and accepted as a careful and faithful perpetuation of the position of the original corner

C. Description of monument for corner and accessories established to perpetuate locating the position of the corner:  
H-3 Set Ottawa County Remon Cap on 3/4" pipe cemented in mon box

Set Ottawa County Remon Tag & Nail in N side 10" Ash S38W 67.65'  
Set Ottawa County Remon Tag & Nail in E side 10" Pine South 35.33'  
Set Ottawa County Remon Tag & Nail in E side 30" Ash N20W 87.16'  
Set "X" on top W end 16' CMP S30E 28.66'  
Set "X" on top E end 16" CMP N42W 33.33'

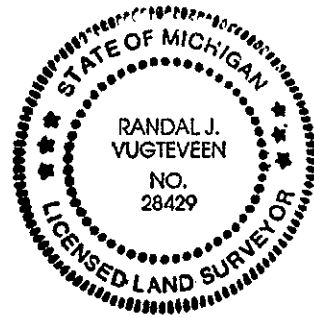

Signed by *Randal J. Vugteveen* Date Nov 5, 1993  
Surveyor's Michigan License No. 28429

FORM APPROVED BY MICHIGAN STATE BOARD OF LAND SURVEYORS, JAN. 28, 1971  
REVISED MAY 14, 1975  
REVISED JAN., 1983