

**SURVEY & REMONUMENTATION**

**OTTAWA COUNTY REMONUMENTATION**

**RECORDED**

DEC 01 1993

93 NOV 11 AM 11:54

**LAND CORNER RECORDATION CERTIFICATE**  
**Filing Requirement of Act 74, Mich. P.A. 1970**


COMMISSION  
 For corners in **OTTAWA**

*Dorothy Robinson*  
 REGISTER OF DEEDS  
 OTTAWA COUNTY, MI

(County)	Located In:	Corner Code #
1. Public Land Survey	T <u>5N</u> R <u>15W</u>	H-5 (S 1/4 cor Section 10) Holland Twp
	T _____ R _____	
	T _____ R _____	
	T _____ R _____	
2. Property Controlling in Section	S _____ T _____ R _____	
	S _____ T _____ R _____	
3. Miscellaneous Property in Sec.	S _____ T _____ R _____	
	S _____ T _____ R _____	

Register of Deeds Stamp & File Number

4. Lot No. \_\_\_\_\_, Recorded Plat \_\_\_\_\_  
 5. Private Claims \_\_\_\_\_

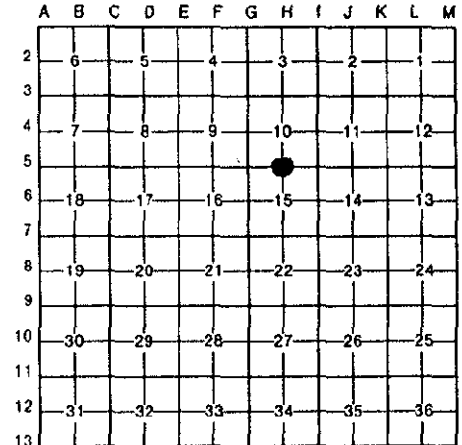

I, Randal J. Vugteveen, in a field survey on September 3, 19 93, do hereby certify that under requirements of P.A. 74, Michigan P.A. of 1970, the corner points mentioned in lines 1 and 2 above were in conformance with regulations and rules therofore as required in the current manual of survey instructions of the United States Department of the Interior, Bureau of Land Management or by a decree of a Court of Law and/or that the corner points mentioned in lines 3, 4 and 5 above were in conformance with the rules of the Michigan Board of Land Surveyors or by a Decree of a Court of Law; established, re-established, monumented, re-monumented, recovered, found as expressed below:

**NOTE: Not more than 4 corners, all in the same town and range, may be recorded on this certificate.**

**A. Description of original monument and accessories and/or subsequent restoration:**  
 H-5 1/4 corner common to Sections 10 & 15


LCRC Liber 2, Page 633 Stone	LCRC Liber 2, Page 813	LCRC Liber 5, Page 113
15" Apple NW 29.46'	Iron Pipe	Cast Iron Monument
T. Pole NE 44.09'	12" Apple N 48.15'	15" Apple N-NW 60.12'
8" Catalpa S 56.07'	10" Apple NW 62.82'	14" Apple NW 78.95'
	14" Apple NW 41.80'	10" Catalpa S 55.75'
	T. Pole N80W 93.15'	8" Tree SW 70.76'

**B. Description of corner evidence found and/or method applied in restoring or reestablishing corner:**  
 H-5 Found cast iron monument in mon box 1.5' North of centerline Riley and accepted as a careful and faithful perpetuation of the position of the original corner

Found Nail in W side 16" Catalpa S 55.64'  
 / Found Nail in N side 15" Maple S53W 70.63'

**C. Description of monument for corner and accessories established to perpetuate locating the position of the corner:**  
 H-5 Set Ottawa County Remon Cap on 4" X 3/4" pipe on monument, cemented in mon box

Set Ottawa County Remon Tag & Nail in W side 16" Catalpa S 55.66'  
 Set Ottawa County Remon Tag & Nail in N side 15" Maple S53W 70.66'  
 NE foundation corner to house #11620 S45W 126.17' Top hydrant N75W 142.50'  
 Top hydrant N81E 255.35'  
 Capped Iron S 33.02'

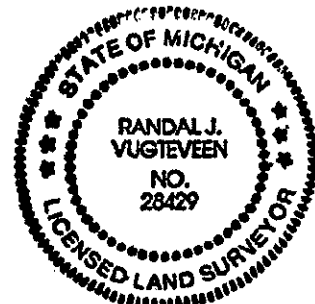

Signed by *Randal J. Vugteveen* Date Nov. 5, 1993  
 Surveyor's Michigan License No. 28429