

FEB 24 2000

OTTAWA COUNTY REMONUMENTATION
LAND CORNER RECORDATION CERTIFICATE
Filing Requirement of Act 74, Mich. P.A. 1970

RECORDED
99 OCT 27 PM 1:50

SECTION

For corners in
Ottawa (County) Located In: Corner Code #

1. Public Land Survey T5N R15W H-11
T R North 1/4 corner
T R Section 34
T R Holland Twp

2. Property Controlling S T R
in Section S T R

3. Miscellaneous S T R
Property in Sec. S T R

Lang
REGISTER OF DEEDS
OTTAWA COUNTY, MI

Register of Deeds Stamp & File Number

4. Lot No. _____ Recorded Plat _____
5. Private Claims _____

	A	B	C	D	E	F	G	H	I	J	K	L	M
1													
2	6	5	4	3	2	1							
3													
4	7	8	9	10	11	12							
5													
6	18	17	16	15	14	13							
7													
8	19	20	21	22	23	24							
9													
10	30	29	28	27	26	25							
11													
12	31	32	33	34	35	36							
13													

I, STEVE LAMPEN, in a field survey on SEPT. 14 1999, do hereby certify that under requirements of P.A. 74, Michigan P.A. of 1970, the corner points mentioned in lines 1 and 2 above were in conformance with regulations and rules therefore as required in the current manual of survey instructions of the United States Department of the Interior, Bureau of Land Management or by a decree of a Court of Law and/or that the corner points mentioned in lines 3, 4 and 5 above were in conformance with the rules of the Michigan Board of Land Surveyors or by a Decree of a Court of Law; established, re-established, monumented, re-monumented, recovered, found as expressed below:

NOTE: Not more than 4 corners, all in the same town and range, may be recorded on this certificate.

A. Description of original monument and accessories and/or subsequent restoration:

H-11	LCRC L-3, P-22	[ERRONEOUSLY RECORDED]	LCRC L-2, P-535
GLO-Brookfield-1832	Clapp - 1975		Verba - 1974
1/4 Section Post on true line	Set CIM		Found Mon Box in CL 16 th St
Beech 10 S51W 8	8" Elm NE 0.5		On N & S fence line
Beech 20 N20E 19	20" Ash NW 25.4		Power Pole 180° 46.94
	6" Ash S 77.5		Power Pole 241° 108.32
	CL Drain W 10.0		Power Pole 294° 294.32

B. Description of corner evidence found and/or method applied in restoring or reestablishing corner:
H-11 Found nothing, 16th Street has been widened to a Boulevard. Reset corner from Holland Engineering Section Measurements. Set corner fits the monumentation of several Plats and surveys. SEE SKETCH ON BACK.


Set an Ottawa County Remonumentation iron and cap at the position of the old iron and accepted it as a careful And faithful perpetuation of the position of the original corner.

FILED APPROVED 9/20/99
[Signature]

C. Description of monument for corner and accessories established to perpetuate locating the position of the corner:

H-11 Ottawa County Remonumentation iron and cap
Azimuth = Michigan State Plane Grid Direction

Remonumentation tag in N side 8" Oak	184°40'	68.19
Hydrant, top centerline	285°15'	172.49
SW corner building, foundation	65°00'	212.99
CL 3" Maple	276°29'	37.46
North edge East and West conc sidewalk	0°27'	49.86
Tree line towards the North	West	0'

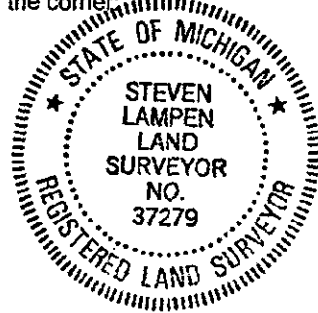


\$11.00 CORNER
Receipt #61757

Signed by Steven Lampen Date OCTOBER 16, 1999
Surveyor's Michigan License No. 37279

FEB 24 2000

SECTION

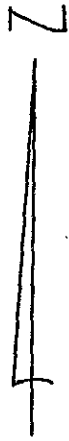

G-II

H-II

L-II

