

SURVEY & REMONUMENTATION

APR 05 1996

OTTAWA COUNTY REMONUMENTATION

COMMISSION

LAND CORNER RECORDATION CERTIFICATE

Filing Requirement of Act 74, Mich. P.A. 1970

For corners in OTTAWA
(County)

	Located In:		Corner Code #
1. Public Land Survey	5N	15W	H-13 (S 1/4 cor Section 34) Holland Twp.
	T	R	
	T	R	
	T	R	
2. Property Controlling in Section	S	T	R
	S	T	R
3. Miscellaneous Property in Sec.	S	T	R
	S	T	R

RECORDED

95 NOV 29 PM 1:43

Randy D. Redwood
REGISTER OF DEEDS
OTTAWA COUNTY, MI

Register of Deeds Stamp & File Number

4. Lot No. _____, Recorded Plat _____
5. Private Claims _____

	A	B	C	D	E	F	G	H	I	J	K	L	M
2	6	5	4	3	2	1							
3													
4	7	8	9	10	11	12							
5													
6	18	17	16	15	14	13							
7													
8	19	20	21	22	23	24							
9													
10	30	29	28	27	26	25							
11													
12	31	32	33	34	35	36							
13													

I, Randal J. Vugteveen, in a field survey on November 17, 19 95, do hereby certify that under requirements of P.A. 74, Michigan P.A. of 1970, the corner points mentioned in lines 1 and 2 above were in conformance with regulations and rules therefore as required in the current manual of survey instructions of the United States Department of the Interior, Bureau of Land Management or by a decree of a Court of Law and/or that the corner points mentioned in lines 3, 4 and 5 above were in conformance with the rules of the Michigan Board of Land Surveyors or by a Decree of a Court of Law; established, re-established, monumented, re-monumented, recovered, found as expressed below:

NOTE: Not more than 4 corners, all in the same town and range, may be recorded on this certificate.

A. Description of original monument and accessories and/or subsequent restoration:

H-13 Common corner to Section 34

1832 - Lyon	Liber 5, Page 365
Set HMP	Set cast mon to replace Sec. corner
Sugar N87 1/2 E50 8 Links	removed during san. const. / N 2635.85'
Sugar N72 1/2 W19 8 Links	Center of Section 34 / W 2661.20' SW
	corner of Section 34 / E 659.38' SW corner
	of Kenwood Hgts Sub / NW 32.62' Survey
	nail & tag S side PP / N 56.24' PK E side
	12" Ash / ESE 73.65' 16-D S side 40"
	Maple / S 52.25' 16-D E side 12" Elm / SW

B. Description of corner evidence found and/or method applied in restoring or reestablishing corner:


H-13 Found O.C. Remon Cap cemented in mon box on C/L E 32nd St. & C/L tree line N, between Beech Creek Dr. N & Productions Place S and accepted as a careful and faithful perpetuation of the position of the original corner
N 56.19' PK E side 12" Oak
ESE 73.40' 16-D S side 40" Oak
SW 52.05' PK NW side 24" Ash

PIA. 345 OTTAWA COUNTY
PEER APPROVED 11/20/95
Randy D. Redwood
RDR

C. Description of monument for corner and accessories established to perpetuate locating the position of the corner:

H-13 Ottawa County Remon Cap cemented in mon box

Found red cap cemented in mon box Az. 270 deg 127.14' (Allegan Corner)
Set Ottawa County Remon Nail & Tag in E side 30" Ash Az. 216 deg 52.09'
Set Ottawa County Remon Nail & Tag in S side 40" Oak Az. 117 deg 73.82'
Fount Ottawa County Remon Nail & Tag in W side 14" Ash Az. 357 deg 56.32'
Set Ottawa County Remon Nail & Tag in W side p. pole Az. 329 deg 33.18'

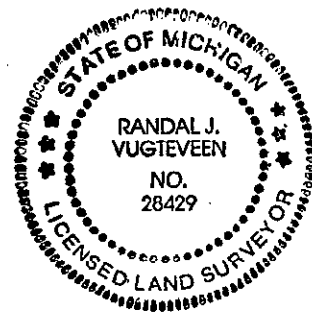

Signed by *Randal J. Vugteveen*
Surveyor's Michigan License No. 28429

Date Nov. 20, 1995