

DEC 01 1998

Ottawa County Remonumentation
LAND CORNER RECORDATION CERTIFICATE
Filing Requirement of Act 74, Mich. P.A. 1970

RECORDED

98 MAY 22 PM 4: 06

SECTION

For corners in

<u>Ottawa</u> (County)	Located In:	Corner Code #
1. Public Land Survey	T <u>5N</u> R <u>15W</u>	I-1 (NW, 2)
	T _____ R _____	Holland Twp.
	T _____ R _____	_____
	T _____ R _____	_____
2. Property Controlling in Section	S _____ T _____ R _____	_____
	S _____ T _____ R _____	_____
3. Miscellaneous Property in Sec.	S _____ T _____ R _____	_____
	S _____ T _____ R _____	_____
4. Lot No. _____, Recorded Plat _____		
5. Private Claims _____		

Angie [Signature]
REGISTER OF DEEDS
OTTAWA COUNTY, MI

Register of Deeds Stamp & File Number

I, John C. Bueche, in a field survey on March 19, 19 98, do hereby certify that under requirements of P.A. 74, Michigan P.A. of 1970, the corner points mentioned in lines 1 and 2 above were in conformance with regulations and rules therefore as required in the current manual of survey instructions of the United States Department of the Interior, Bureau of Land Management or by a decree of a Court of Law and/or that the corner points mentioned in lines 3, 4 and 5 above were in conformance with the rules of the Michigan Board of Land Surveyors or by a Decree of a Court of Law; established, re-established, monumented, re-monumented, recovered, found as expressed below:

A	B	C	D	E	F	G	H	I	J	K	L	M
2	6	5	4	3	2	1						
3												
4	7	8	9	10	11	12						
5												
6	18	17	16	15	14	13						
7												
8	19	20	21	22	23	24						
9												
10	30	29	28	27	26	25						
11												
12	31	32	33	34	35	36						
13												

NOTE: Not more than 4 corners, all in the same town and range, may be recorded on this certificate.

A. Description of original monument and accessories and/or subsequent restoration:

I-1 GLO	LCRC L1, P23, May, 1971
Lucius Lyon, 1831	Fnd. SW cor. 35, 6-15 & set
North boundary 1.10 East	NW Sec. 2, 5-15 according
of post, set cor. secs. 2 & 3	to recorded GLO job
Beech 8 S 55 E 27	110 lks. or 72.60'
Beech 14 S 20 W 57	Nail in TP NW 62.95'
	C/L hydt. NW 53.58'
	Nail in PP SW 48.54'
	C/L st. sign SW 47.52'
	Nail in PP SE 80.71'

B. Description of corner evidence found and/or method applied in restoring or reestablishing corner:


I-1 Found leaning 4" Harrison Mon. 6" long in leaning Mon. Box; on C/L bit. E-W, on C/L bit. South checked ±0.10' for dist. & line straightened
Set 3/4" x 24" Pin with Ottawa Co. Cap in straighten Mon. Box; placed Mon. 72.60'
East of SW cor. 35, 6-15 on Township Line I-13 (SE 34) & J-13 (S 1/4 35) 6-15
Nail in PP SW 48.54'± Nail in PP SE 80.71'±

And is accepted as a careful and faithful perpetuation of the position of the original corner.

PEER APPROVED 4/20/98

C. Description of monument for corner and accessories established to perpetuate locating the position of the corner:

I-1 Set 3/4" x 24" Pin with Ottawa Co. Cap in Mon. Box on Township Line
C/L hydt. N 48° W 47.04'
Ottawa Co. Remon. Tag & Nail in NE side PP S 42° W 48.56'
Ottawa Co. Remon. Tag & Nail in NE side PP S 65° E 81.33'
SW cor. pole barn (metal) N 2° E 89.43'
SE cor. pole barn (metal) N 26° E 99.59'
On C/L bit. road E-W; on C/L bit. road South
Ottawa Co. Mon. in Mon. Box West 72.60' I-13 (SE 34, 6-15)

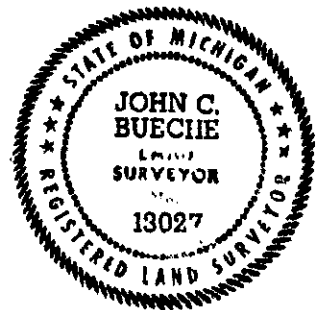

\$ 11.00 CORNER
\$ 2.00 PHOTO

Signed by John C. Bueche
John C. Bueche, P.S. 13027
Surveyor's Michigan License No. _____

Date 4-1-98

SURVEY &
REMONUMENTATION

DEC 01 1998

SECTION

