

DEC 01 1993

OTTAWA COUNTY REMONUMENTATION

RECORDED

93 NOV 11 AM 11:53

COMMISSION

LAND CORNER RECORDATION CERTIFICATE

Filing Requirement of Act 74, Mich. P.A. 1970

Ralphie R. Riddman
REGISTER OF DEEDS
OTTAWA COUNTY, MI

For corners in OTTAWA

(County)

Located In:

Corner Code #

- | | | | |
|------------------------------------|--------------------------|-------------|-----|
| 1. Public Land Survey | T <u>5N</u> R <u>15W</u> | I-5 (SW | cor |
| | T _____ R _____ | Section 11) | |
| | T _____ R _____ | Holland Twp | |
| | T _____ R _____ | | |
| 2. Property Controlling in Section | S _____ T _____ R _____ | | |
| | S _____ T _____ R _____ | | |
| 3. Miscellaneous Property in Sec. | S _____ T _____ R _____ | | |
| | S _____ T _____ R _____ | | |

Register of Deeds Stamp & File Number

4. Lot No. _____, Recorded Plat _____
5. Private Claims _____

A	B	C	D	E	F	G	H	I	J	K	L	M
2	6	5	4	3	2	1						
3												
4	7	8	9	10	11	12						
5												
6	18	17	16	15	14	13						
7												
8	19	20	21	22	23	24						
9												
10	30	29	28	27	26	25						
11												
12	31	32	33	34	35	36						
13												

I, Randal J. Vugteveen, in a field survey on September 16, 1993, do hereby certify that under requirements of P.A. 74, Michigan P.A. of 1970, the corner points mentioned in lines 1 and 2 above were in conformance with regulations and rules therefore as required in the current manual of survey instructions of the United States Department of the Interior, Bureau of Land Management or by a decree of a Court of Law and/or that the corner points mentioned in lines 3, 4 and 5 above were in conformance with the rules of the Michigan Board of Land Surveyors or by a Decree of a Court of Law; established, re-established, monumented, re-monumented, recovered, found as expressed below:

NOTE: Not more than 4 corners, all in the same town and range, may be recorded on this certificate.

A. Description of original monument and accessories and/or subsequent restoration:
I-5 common corner to Sections 10, 11, 14 & 15


LCRC Liber 1, Page 457	LCRC Liber 5, Page 69	LCRC Liber 6, Page 16
O.C.R.C.	O.C. Monument	O.C. Monument
Nail in P. Pole SW 41.31'	N&T NE side P. pole SW 40.65' / centerline	PK on centerline 112th N 100.04' / PK on
Nail in P. Pole NE 76.0'	top of hydrant SE 57.89' / Nail in SE side	NW side P. Pole NE 75.92' / PK on
Centerline St. Sign SE 35.15'	P. Pole NE 76.29' / PK on centerline	centerline Riley E 75.13' / Centerline top
	street W 200.10' / PK in Punt N 199.99'	of hydrant SE 57.89' / Nail in N side P.
		Pole SW 41.15'

B. Description of corner evidence found and/or method applied in restoring or reestablishing corner:
I-5 Found cast iron monument in mon box at centerline "X" of 112th & Riley and accepted as a careful and faithful perpetuation of the position of the original corner

Top of hydrant S37E 57.87' / Nail in N side P Pole S60W 41.11' / PK in NW side P. Pole N40E 75.93'

C. Description of monument for corner and accessories established to perpetuate locating the position of the corner:
I-5 Cast Iron Monument in Mon Box

- NE corner block foundation house #3191 S44W 218.69'
- NE foundation corner metal building S73W 230.45'
- SE foundation garage corner house #3210 N55W 213.53'
- Set Ottawa County Remon Tag & nail in NW side P. Pole N40E 76.11'
- PK on centerline 112th Avenue North 100.10

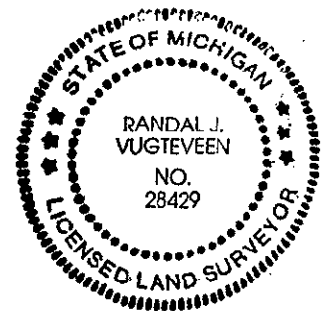

Signed by Randal J. Vugteveen
Surveyor's Michigan License No. 28429

Date Nov 5, 1993