

SURVEY & REMONUMENTATION

DEC 01 1993

COMMISSION

OTTAWA COUNTY REMONUMENTATION

LAND CORNER RECORDATION CERTIFICATE
Filing Requirement of Act 74, Mich. P.A. 1970

RECORDED

93 NOV 11 AM 11:53

D. J. Williams
REGISTER OF DEEDS
OTTAWA COUNTY, MI

For corners in **OTTAWA**

(County)

Located In:

Corner Code #

1. Public Land Survey	T	5N	R	15W	I-6 (W 1/4 cor
	T		R		Section 14)
	T		R		Holland Twp
	T		R		
2. Property Controlling in Section	S		T	R	
	S		T	R	
3. Miscellaneous Property in Sec.	S		T	R	
	S		T	R	

Register of Deeds Stamp & File Number

4. Lot No. _____, Recorded Plat _____
5. Private Claims _____

A	B	C	D	E	F	G	H	I	J	K	L	M
2	6		5		4		3		2		1	
3												
4	7		8		9		10		11		12	
5												
6	18		17		16		15	●	14		13	
7												
8	19		20		21		22		23		24	
9												
10	30		29		28		27		26		25	
11												
12	31		32		33		34		35		36	
13												

I, Randal J. Vugteveen, in a field survey on September 16, 1993, do hereby certify that under requirements of P.A. 74, Michigan P.A. of 1970, the corner points mentioned in lines 1 and 2 above were in conformance with regulations and rules therefore as required in the current manual of survey instructions of the United States Department of the Interior, Bureau of Land Management or by a decree of a Court of Law and/or that the corner points mentioned in lines 3, 4 and 5 above were in conformance with the rules of the Michigan Board of Land Surveyors or by a Decree of a Court of Law; established, re-established, monumented, re-monumented, recovered, found as expressed below:

NOTE: Not more than 4 corners, all in the same town and range, may be recorded on this certificate.


A. Description of original monument and accessories and/or subsequent restoration:
1-6 1/4 corner common to Sections 14 & 15

LCRC Liber 1, Page 457
"T" Iron
Nail in P. Pole NE 59.48' / Nail in T. Pole E-SE 93.78' / Nail in t. Pole W 24.88'

B. Description of corner evidence found and/or method applied in restoring or reestablishing corner:
I-6 Found "T" iron in Mon box 1' West of centerline 112th & 163' South of Canyon Creek Dr. and accepted as careful and faithful perpetuation of the position of the original corner
Nail in N side P. Pole N58E 59.47'

C. Description of monument for corner and accessories established to perpetuate locating the position of the corner:
I-6 Removed "T" iron and set Ottawa County Remon Cap on 24" X 3/4" pipe cemented in mon box

Set Ottawa County Remon Tag & Nail in N side P. Pole N58E 59.50'
Set Ottawa County Remon Tag & Nail in E side L. Pole N8W 165.50'
Set Ottawa County Remon Tag & Nail in W side P. Pole S21E 140.09'
Found capped iron E 33.01'
NE garage corner brick house #2809 N73W 219.34'

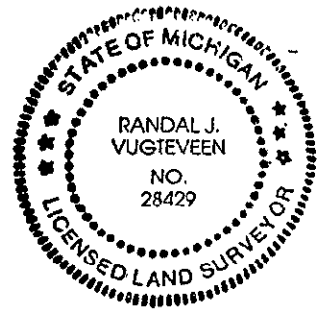

Signed by *Randal J. Vugteveen* Date Nov 5, 1993
Surveyor's Michigan License No. 28429