

**SURVEY &
DOCUMENTATION**

DEC 01 1993

OTTAWA COUNTY REMONUMENTATION

RECORDED

93 NOV 11 AM 11:53

LAND CORNER RECORDATION CERTIFICATE

Filing Requirement of Act 74, Mich. P.A. 1970

Ralph S. Hollman
REGISTER OF DEEDS
OTTAWA COUNTY, MI


COMMISSION

For corners in **OTTAWA**

	Located In:	Corner Code #
1. Public Land Survey	T <u>5N</u> R <u>15W</u>	I-7 (SW cor
	T _____ R _____	Section 14)
	T _____ R _____	Holland Twp
	T _____ R _____	
	T _____ R _____	
2. Property Controlling in Section	S _____ T _____ R _____	
	S _____ T _____ R _____	
3. Miscellaneous Property in Sec.	S _____ T _____ R _____	
	S _____ T _____ R _____	
4. Lot No. _____, Recorded Plat _____		
5. Private Claims _____		

Register of Deeds Stamp & File Number

I, Randal J. Vugteveen, in a field survey on September 16, 1993, do hereby certify that under requirements of P.A. 74, Michigan P.A. of 1970, the corner points mentioned in lines 1 and 2 above were in conformance with regulations and rules therefore as required in the current manual of survey instructions of the United States Department of the Interior, Bureau of Land Management or by a decree of a Court of Law and/or that the corner points mentioned in lines 3, 4 and 5 above were in conformance with the rules of the Michigan Board of Land Surveyors or by a Decree of a Court of Law; established, re-established, monumented, re-monumented, recovered, found as expressed below:

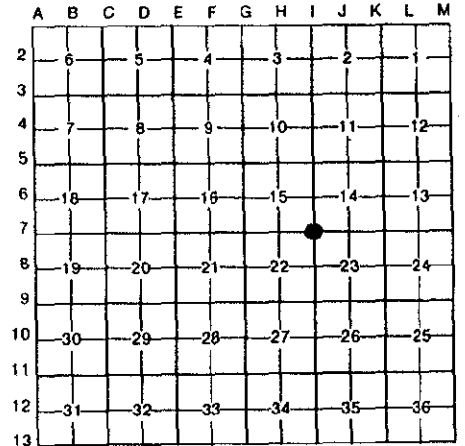

NOTE: Not more than 4 corners, all in the same town and range, may be recorded on this certificate.

**A. Description of original monument and accessories and/or subsequent restoration:
I-7 Corner common to Sections 14, 15, 22 & 23**


LCRC Liber 2, Page 161	LCRC Liber 2, Page 633	LCRC Liber 5, Page 20
Boat Spike	Boat Spike	Set Cast Monument
P. Pole NE 108.65'	Telephone pole SW 35.15'	Nail in S side P. Pole NW 46.08' / Nail in SW side P. Pole N-NE 108.72' / Nail in N. side 24" Ash W-NW 83.90' / Centerline top of Hydrant E-NE 48.71'
Centerline St. Sign SE 42.36'	Street sign SE 42.35'	
20' Ash SW 82.72'	Power Pole NE 108.78'	
Telephone pole SW 35.20'		

**B. Description of corner evidence found and/or method applied in restoring or reestablishing corner:
I-7 Found cast iron mon. flush with pavement at centerline "X" of James & 112th and accepted as a careful and faithful perpetuation of the position of the original corner**

Top of Hydrant E-NE 48.61'

**C. Description of monument for corner and accessories established to perpetuate locating the position of the corner:
I-7 Cast Iron Monument**

- Set Ottawa County Remon Tag & Nail in S side P. Pole N 55W 46.08'
- Set Ottawa County Remon Tag & Nail in W side L. Pole S47E 53.51'
- Set Ottawa County Remon Tag & Nail in NW side P. Pole S43W 57.60'
- SW foundation corner house #1118 N35E 120.98'
- NE foundation corner metal building S33W 206.73'

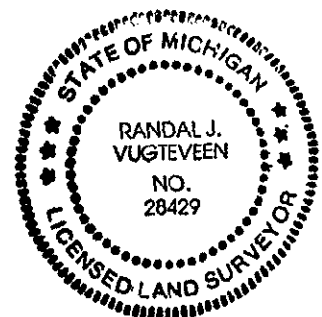

Signed by Randal J. Vugteveen Date Nov 5, 1993
Surveyor's Michigan License No. 28429