

SURVEY & REMONUMENTATION

APR 24 1995

OTTAWA COUNTY REMONUMENTATION

RECORDED

COMMISSION

LAND CORNER RECORDATION CERTIFICATE

Filing Requirement of Act 74, Mich. P.A. 1970

94 DEC 14 AM 9:41

For corners in
OTTAWA

(County)

Located In:

Corner Code #:

1. Public Land Survey	<u>5N</u> <u>R15W</u>	<u>I-8 (E 1/4 cor</u> <u>Section 22)</u> <u>Holland Twp.</u>
	T _____ R _____	
	T _____ R _____	
	T _____ R _____	
2. Property Controlling in Section	S _____ T _____ R _____	
	S _____ T _____ R _____	
3. Miscellaneous Property in Sec.	S _____ T _____ R _____	
	S _____ T _____ R _____	

Robert L. Halverson
REGISTER OF DEEDS
OTTAWA COUNTY, MI

Register of Deeds Stamp & File Number

4. Lot No. _____, Recorded Plat _____
5. Private Claims _____

	A	B	C	D	E	F	G	H	I	J	K	L	M
2	6	5	4	3	2	1							
3													
4	7	8	9	10	11	12							
5													
6	16	17	16	15	14	13							
7													
8	19	20	21	22	23	24							
9													
10	30	29	28	27	26	25							
11													
12	31	32	33	34	35	36							
13													

I, Randal J. Vugteveen, in a field survey on December 9, 19 94, do hereby certify that under requirements of P.A. 74, Michigan P.A. of 1970, the corner points mentioned in lines 1 and 2 above were in conformance with regulations and rules therefore as required in the current manual of survey instructions of the United States Department of the Interior, Bureau of Land Management or by a decree of a Court of Law and/or that the corner points mentioned in lines 3, 4 and 5 above were in conformance with the rules of the Michigan Board of Land Surveyors or by a Decree of a Court of Law; established, re-established, monumented, re-monumented, recovered, found as expressed below:

NOTE: Not more than 4 corners, all in the same town and range, may be recorded on this certificate.

A. Description of original monument and accessories and/or subsequent restoration:

I-8 Common corner to Sections 22 & 23

1832 - Brookfield

Set post

Beech 20" N63W 40 Links

B. Ash 12" S12W 25 Links

Liber 1, Page 89

Nail in face of P. pole SE 68.00'

Nail in face of P. pole NE 68.70'

Nail in face of T. pole NW 44.20'

Street sign SE 45.72'

Bldg corner NE 95.10'

Liber 5, Page 19

Replace with cast monument

NW 44.38' PK & flag in NE side TP

NE 95.18' SW cor block frnd to bldg.

SE 61.30' PK & flag E side PP

SSW 112.40' nail & washer N side PP

B. Description of corner evidence found and/or method applied in restoring or reestablishing corner:

I-8 Found CIM at intersection of Lakewood Boulevard & 112th Avenue and accepted as a careful and faithful perpetuation of the position of the original corner

SW P. pole 112.30'

Building corner NE 95.10'

NE 95.29' SW cor block frnd to bldg.

SSW 112.41' nail & washer N side PP

P.A. 345 OTTAWA COUNTY

PEER APPROVED 12/12/94

Rudolf P. Nedewell

C. Description of monument for corner and accessories established to perpetuate locating the position of the corner:

I-8 Cast Iron Monument


AZ = Michigan State Grid Direction

SW corner block foundation #11185 Chicago Drive AZ. 63 deg 95.29'

Set Ottawa County Remon Tag & Nail in E side P. pole AZ. 200 deg 94.83'

Set Ottawa County Remon Tag & Nail in N side P. pole AZ. 127 deg 97.19'

Set Ottawa County Remon Tag & Nail in NE side L. pole AZ. 316 deg 45.26'

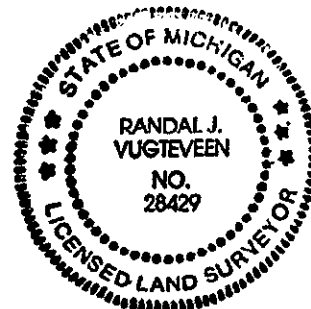

Signed by

Randal J. Vugteveen

Date

Dec 12, 1994

Surveyor's Michigan License No.

28429