

**SURVEY & REMONUMENTATION**

**OTTAWA COUNTY REMONUMENTATION**

**APR 05 1996**

**LAND CORNER RECORDATION CERTIFICATE**  
**Filing Requirement of Act 74, Mich. P.A. 1970**

For corners in **COMMISSION**  
**OTTAWA**

**RECORDED**

**95 NOV 15 PM 2:09**

*R. J. Vugteveen*  
**REGISTER OF DEEDS**  
**OTTAWA COUNTY, MI**

	Located In:	Corner Code #
1. Public Land Survey	<u>15N</u> <u>R15W</u>	<u>I-10 (E 1/4 cor</u> <u>Section 27)</u> <u>Holland Twp.</u>
	T _____ R _____	_____
	T _____ R _____	_____
	T _____ R _____	_____
2. Property Controlling in Section	S _____ T _____ R _____	_____
	S _____ T _____ R _____	_____
3. Miscellaneous Property in Sec.	S _____ T _____ R _____	_____
	S _____ T _____ R _____	_____
4. Lot No. _____, Recorded Plat _____		
5. Private Claims _____		

**Register of Deeds Stamp & File Number**

A	B	C	D	E	F	G	H	I	J	K	L	M
2	6	5	4	3	2	1						
3												
4	7	8	9	10	11	12						
5												
6	13	17	16	15	14	13						
7												
8	19	20	21	22	23	24						
9												
10	30	29	28	27	26	25						
11												
12	31	32	33	34	35	36						
13												

I, Randal J. Vugteveen, in a field survey on October 17, 19 95, do hereby certify that under requirements of P.A. 74, Michigan P.A. of 1970, the cornerpoints mentioned in lines 1 and 2 above were in conformance with regulations and rules therefore as required in the current manual of survey instructions of the United States Department of the Interior, Bureau of Land Management or by a decree of a Court of Law and/or that the corner points mentioned in lines 3, 4 and 5 above were in conformance with the rules of the Michigan Board of Land Surveyors or by a Decree of a Court of Law; established, re-established, monumented, re-monumented, recovered, found as expressed below:

**NOTE: Not more than 4 corners, all in the same town and range, may be recorded on this certificate.**

**A. Description of original monument and accessories and/or subsequent restoration:**  
 I-10 Common corner to Sections 26 & 27

1832 - Lyon	Liber 2, Page 1
Set HMP	Boat Spike mon box
Beech N55 W7 10 Links	NE 36.15' PP
Beech S57 E25 20 Links	SE 36.58' PP
	NW 51.28' PP


**B. Description of corner evidence found and/or method applied in restoring or reestablishing corner:**

I-10 Found boat spike in mon box @ centerline "X" E 8th St. & Country Club Rd. and accepted as a careful and faithful perpetuation of the position of the original corner  
 PK in NW side p. pole 35.96'  
 PK in NE side p. pole 36.53'

**P.A. 345 OTTAWA COUNTY**  
**PEER APPROVED** 10/23/95  
*Keddy P. Nedewell*  
*JDN*

**C. Description of monument for corner and accessories established to perpetuate locating the position of the corner:**

I-10 Removed boat spike, set 3/4" X 24" solid bar with Ottawa County Remon cap in mon box  
 SW corner concrete brick ledge house #1177 Az. 39 deg 90.97'  
 SE brick corner garage #188 Az. 310 deg 81.58'  
 NE foundation corner house #200 Az. 223 deg 113.30'  
 Set Ottawa County Remon Nail & Tag in NE side p. pole Az. 135 deg 36.53'

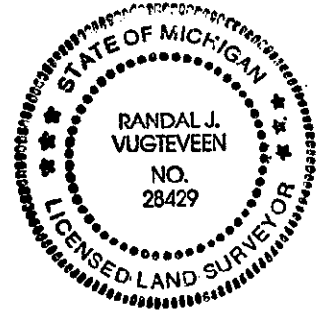

Signed by *Randal J. Vugteveen*  
 Surveyor's Michigan License No. 28429

Date Oct. 20, 1995