

**SURVEY &
REMONUMENTATION**

APR 05 1996

OTTAWA COUNTY REMONUMENTATION

COMMISSION

LAND CORNER RECORDATION CERTIFICATE

Filing Requirement of Act 74, Mich. P.A. 1970

For corners in
OTTAWA
(County)

	Located in:	Corner Code #
1. Public Land Survey	<u>T5N R15W</u>	<u>J-9 (N 1/4 cor Section 26)</u> <u>Holland Twp</u>
	T _____ R _____	_____
	T _____ R _____	_____
	T _____ R _____	_____
2. Property Controlling in Section	S _____ T _____ R _____	_____
	S _____ T _____ R _____	_____
3. Miscellaneous Property in Sec.	S _____ T _____ R _____	_____
	S _____ T _____ R _____	_____

RECORDED

95 NOV 15 PM 2:08

Ralphie Chubb
REGISTER OF DEEDS
OTTAWA COUNTY, MI

Register of Deeds Stamp & File Number

4. Lot No. _____, Recorded Plat _____
5. Private Claims _____

I, Randal J. Vugteveen, in a field survey on October 17, 19 95, do hereby certify that under requirements of P.A. 74, Michigan P.A. of 1970, the corner points mentioned in lines 1 and 2 above were in conformance with regulations and rules therefore as required in the current manual of survey instructions of the United States Department of the Interior, Bureau of Land Management or by a decree of a Court of Law and/or that the corner points mentioned in lines 3, 4 and 5 above were in conformance with the rules of the Michigan Board of Land Surveyors or by a Decree of a Court of Law; established, re-established, monumented, re-monumented, recovered, found as expressed below:

A	B	C	D	E	F	G	H	I	J	K	L	M
2	6	5	4	3	2	1						
3												
4	7	8	9	10	11	12						
5												
6	18	17	16	15	14	13						
7												
8	19	20	21	22	23	24						
9												
10	30	29	28	27	26	25						
11												
12	31	32	33	34	35	36						
13												

NOTE: Not more than 4 corners, all in the same town and range, may be recorded on this certificate.

A. Description of original monument and accessories and/or subsequent restoration:
J-9 Common corner to Section 23 & 26


1832 - Lyon	Liber 1 Page 829
Set 1/4 Section post	S 4.05' to 6" pine
Beech S44 W32 12 Links	NW 3.35' to PP
Beech N64 E23 18 Links	

B. Description of corner evidence found and/or method applied in restoring or reestablishing corner:
J-9 Found square conc mon 663.09' W of centerline "X" Perry St. E & 106th St. N, under power lines and accepted as a careful and faithful perpetuation of the position of the original corner
South 4' to 12" Twin Pine
Found nail in E side p. pole NW 3.35'

P.A. 345 OTTAWA COUNTY
PEER APPROVED 10/23/95
Randy P. Nedeweld
RDN

C. Description of monument for corner and accessories established to perpetuate locating the position of the corner:
J-9 Removed conc mon, set 3/4" X 36" solid bar with Ottawa County Remon cap

- Set Ottawa County Remon Nail & Tag in NE side p. pole Az. 330 deg 3.35'
- Set Ottawa County Remon Nail & Tag in W side 12" Twin Pine Az. 180 deg 4.25'
- Set Ottawa County Remon Nail & Tag in SE side 12" Pine stump Az. 250 deg 4.83'
- SW corner 5" X 5" angle iron C.P. tower 1' above ground Az. 35 deg 86.46'

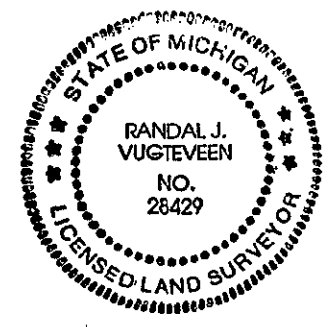

Signed by *Randal J. Vugteveen*
Surveyor's Michigan License No. 28429

Date Oct. 20, 1995

FORM APPROVED BY MICHIGAN STATE BOARD OF LAND SURVEYORS, JAN. 20, 11
REVISED MAY 14, 11
REVISED JAN., 11