

SURVEY & REMONUMENTATION

APR 05 1996

COMMISSION

OTTAWA COUNTY REMONUMENTATION

LAND CORNER RECORDATION CERTIFICATE
Filing Requirement of Act 74, Mich. P.A. 1970

For corners in OTTAWA
(County)

Located In: Corner Code #

- | | | | |
|------------------------------------|----|-----|-----------------|
| 1. Public Land Survey | 5N | 15W | J-11 (S 1/4 COR |
| | T | R | Section 26) |
| | T | R | Holland Twp |
| | T | R | |
| 2. Property Controlling in Section | S | T | R |
| | S | T | R |
| 3. Miscellaneous Property in Sec. | S | T | R |
| | S | T | R |
4. Lot No. _____, Recorded Plat _____
5. Private Claims _____

RECORDED

95 NOV 15 PM 2:08

Richard Redmond
REGISTER OF DEEDS
OTTAWA COUNTY, MI

Register of Deeds Stamp & File Number

I, Randal J. Vugteveen, in a field survey on October 17, 19 95, do hereby certify that under requirements of P.A. 74, Michigan P.A. of 1970, the corner points mentioned in lines 1 and 2 above were in conformance with regulations and rules therefore as required in the current manual of survey instructions of the United States Department of the Interior, Bureau of Land Management or by a decree of a Court of Law and/or that the corner points mentioned in lines 3, 4 and 5 above were in conformance with the rules of the Michigan Board of Land Surveyors or by a Decree of a Court of Law, established, re-established, monumented, re-monumented, recovered, found as expressed below:

NOTE: Not more than 4 corners, all in the same town and range, may be recorded on this certificate.

	A	B	C	D	E	F	G	H	I	J	K	L	M
2	6	5	4	3	2	1							
3													
4	7	8	9	10	11	12							
5													
6	16	17	18	15	14	13							
7													
8	19	20	21	22	23	24							
9													
10	30	29	28	27	26	25							
11													
12	31	32	33	34	35	36							
13													

A. Description of original monument and accessories and/or subsequent restoration:

J-11 Common corner to Section 26 & 35	Liber 2, Page 1
1832 - Lyon	RR spike
Set 1/4 Section post	NW pp 59.64'
Hemlock S39 W22 20 Links	SSE tp 36.28'
Hemlock N12 E27 18 Links	NE pp 57.10'

B. Description of corner evidence found and/or method applied in restoring or reestablishing corner:

J-11 Found 1/2" rebar in mon box @ centerline "X" E 16th St. & Quarterline Rd. and accepted as a careful and faithful perpetuation of the position of the original corner


PK in W side p. pole 59.68'
PK in W side t. pole 36.15'
PK in E side p. pole 56.96'

PA. 345 OTTAWA COUNTY
PEER APPROVED 10/23/95
Richard D. Redmond
RD

C. Description of monument for corner and accessories established to perpetuate locating the position of the corner:

J-11 Removed rebar, set 3/4" X 24" solid bar with Ottawa County Remon cap in mon box

Set Ottawa County Remon Nail & Tag in W side p. pole Az. 32 deg 57.08'
Set Ottawa County Remon Nail & Tag in W side p. pole Az. 324 deg 59.70'
Top centerline hydrant Az. 296 deg 50.17'
NW corner brick house Az. 235 deg 136.33'
Set Ottawa County Remon Nail & Tag in W side p. pole Az. 166 deg 36.18'

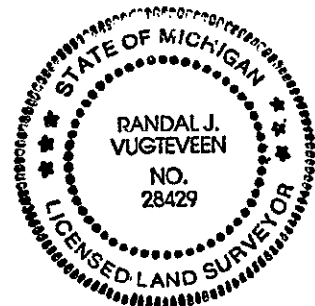

Signed by *Randal J. Vugteveen*
Surveyor's Michigan License No. 28429

Date Oct. 20, 1995