

**SURVEY & REMONUMENTATION**

**OTTAWA COUNTY REMONUMENTATION**

APR 05 1996

**COMMISSION**

**LAND CORNER RECORDATION CERTIFICATE**

Filing Requirement of Act 74, Mich. P.A. 1970

For corners in  
OTTAWA  
(County)

|                                    | Located In: | Corner Code #                               |
|------------------------------------|-------------|---|
| 1. Public Land Survey              | T5N R15W    | J-13 (S 1/4 cor Section 35)<br>Holland Twp. |
| 2. Property Controlling in Section | S T R       |   |
| 3. Miscellaneous Property in Sec.  | S T R       |   |

**RECORDED**

95 NOV 29 PM 1:43

*Rhonda Robinson*  
REGISTER OF DEEDS  
OTTAWA COUNTY, MI

Register of Deeds Stamp & File Number

4. Lot No. \_\_\_\_\_, Recorded Plat \_\_\_\_\_  
5. Private Claims \_\_\_\_\_

|    | A  | B  | C  | D  | E  | F  | G | H | I | J | K | L | M |
|----|----|----|----|----|----|----|---|---|---|---|---|---|---|
| 2  | 6  | 5  | 4  | 3  | 2  |    |   |   |   |   |   |   |   |
| 3  |    |    |    |    |    |    |   |   |   |   |   |   |   |
| 4  | 7  | 8  | 9  | 10 | 11 | 12 |   |   |   |   |   |   |   |
| 5  |    |    |    |    |    |    |   |   |   |   |   |   |   |
| 6  | 18 | 17 | 16 | 15 | 14 | 13 |   |   |   |   |   |   |   |
| 7  |    |    |    |    |    |    |   |   |   |   |   |   |   |
| 8  | 19 | 20 | 21 | 22 | 23 | 24 |   |   |   |   |   |   |   |
| 9  |    |    |    |    |    |    |   |   |   |   |   |   |   |
| 10 | 30 | 29 | 28 | 27 | 26 | 25 |   |   |   |   |   |   |   |
| 11 |    |    |    |    |    |    |   |   |   |   |   |   |   |
| 12 | 31 | 32 | 33 | 34 | 35 | 36 |   |   |   |   |   |   |   |
| 13 |    |    |    |    |    |    |   |   |   |   |   |   |   |

I, Randal J. Vugteveen, in a field survey on November 17, 19 95 do hereby certify that under requirements of P.A. 74, Michigan P.A. of 1970, the corner points mentioned in lines 1 and 2 above were in conformance with regulations and rules therefore as required in the current manual of survey instructions of the United States Department of the Interior, Bureau of Land Management or by a decree of a Court of Law and/or that the corner points mentioned in lines 3, 4 and 5 above were in conformance with the rules of the Michigan Board of Land Surveyors or by a Decree of a Court of Law; established, re-established, monumented, re-monumented, recovered, found as expressed below:

**NOTE: Not more than 4 corners, all in the same town and range, may be recorded on this certificate.**

**A. Description of original monument and accessories and/or subsequent restoration:**

J-13 Common corner to Section 36

|                         |                      |
|-------------------------|----------------------|
| 1832 - Lyon             | Liber                |
| Set HMP                 | Set CIM              |
| Hemlock N21 E9 22 Links | Allegan cor W 89.00' |
| Beech N71 W50 10 Links  | pp NW 129.18'        |
|                         | C/L road N 5'        |
|                         | 2" tree SE 46.93'    |

**B. Description of corner evidence found and/or method applied in restoring or reestablishing corner:**

J-13 Found CIM in mon box 4' South of centerline E 32nd St. and accepted as a careful and faithful perpetuation of the position of the original corner  
Allegan Corner W 88.93 (leaning East)  
MSHD Nail & Tag in NW side p. pole 128.99'  
C/L road N 4'  
8" tree SE 46.93'


P.A. 345 OTTAWA COUNTY  
PEER APPROVED 11/20/95

*Rhonda Robinson*  
807

**C. Description of monument for corner and accessories established to perpetuate locating the position of the corner:**

J-13 Cast Iron Monument in mon box

Found 1" Solid in bit Az. 270 deg 88.93' (leaning East, Allegan Corner)  
Set Ottawa County Remon Nail & Tag in top of East end 36" culvert Az. 240 deg 33.98'  
Set Ottawa County Remon Nail & Tag in SW side p. pole Az. 320 deg 129.28'  
Set Ottawa County Remon Nail & Tag in SE side Twin 5" Ash Az. 60 deg 52.46'  
Set Ottawa County Remon Nail & Tag in SW side Twin 8" Ash Az. 120 deg 46.88'

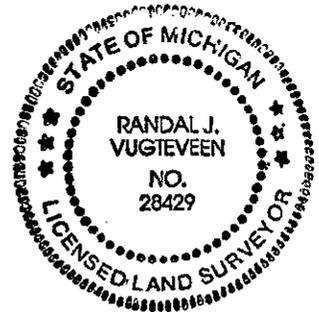

Signed by Randal J. Vugteveen  
Surveyor's Michigan License No. 28429

Date Nov. 20, 1995