

**SURVEY & REMONUMENTATION**

DEC 01 1998

Ottawa County Remonumentation  
**LAND CORNER RECORDATION CERTIFICATE**  
 Filing Requirement of Act 74, Mich. P.A. 1970

RECORDED

99 MAY 22 PM 4:06

For corners in **SECTION**

| <u>Ottawa</u><br>(County)             | Located In:              | Corner Code #       |
|---------------------------------------|--------------------------|---------------------|
| 1. Public Land Survey                 | T <u>5N</u> R <u>15W</u> | <u>K-1 (NW, 1)</u>  |
|                                       | T _____ R _____          | <u>Holland Twp.</u> |
|                                       | T _____ R _____          | _____               |
|                                       | T _____ R _____          | _____               |
| 2. Property Controlling<br>in Section | S _____ T _____ R _____  | _____               |
|                                       | S _____ T _____ R _____  | _____               |
| 3. Miscellaneous<br>Property in Sec.  | S _____ T _____ R _____  | _____               |
|                                       | S _____ T _____ R _____  | _____               |

*Larry Schellert*  
 REGISTER OF DEEDS  
 OTTAWA COUNTY, MI

Register of Deeds Stamp & File Number

4. Lot No. \_\_\_\_\_, Recorded Plat \_\_\_\_\_  
 5. Private Claims \_\_\_\_\_

|    | A  | B  | C  | D  | E  | F  | G | H | I | J | K | L | M |
|----|----|----|----|----|----|----|---|---|---|---|---|---|---|
| 2  | 6  | 5  | 4  | 3  | 2  | 1  |   |   |   |   |   |   |   |
| 3  |    |    |    |    |    |    |   |   |   |   |   |   |   |
| 4  | 7  | 8  | 9  | 10 | 11 | 12 |   |   |   |   |   |   |   |
| 5  |    |    |    |    |    |    |   |   |   |   |   |   |   |
| 6  | 18 | 17 | 16 | 15 | 14 | 13 |   |   |   |   |   |   |   |
| 7  |    |    |    |    |    |    |   |   |   |   |   |   |   |
| 8  | 19 | 20 | 21 | 22 | 23 | 24 |   |   |   |   |   |   |   |
| 9  |    |    |    |    |    |    |   |   |   |   |   |   |   |
| 10 | 30 | 29 | 28 | 27 | 26 | 25 |   |   |   |   |   |   |   |
| 11 |    |    |    |    |    |    |   |   |   |   |   |   |   |
| 12 | 31 | 32 | 33 | 34 | 35 | 36 |   |   |   |   |   |   |   |
| 13 |    |    |    |    |    |    |   |   |   |   |   |   |   |

I, John C. Bueche, in a field survey on March 19, 19 98, do hereby certify that under requirements of P.A. 74, Michigan P.A. of 1970, the corner points mentioned in lines 1 and 2 above were in conformance with regulations and rules therefore as required in the current manual of survey instructions of the United States Department of the Interior, Bureau of Land Management or by a decree of a Court of Law and/or that the corner points mentioned in lines 3, 4 and 5 above were in conformance with the rules of the Michigan Board of Land Surveyors or by a Decree of a Court of Law; established, re-established, monumented, re-monumented, recovered, found as expressed below:

**NOTE: Not more than 4 corners, all in the same town and range, may be recorded on this certificate.**

A. Description of original monument and accessories and/or subsequent restoration:

|                           |                               |
|---------------------------|-------------------------------|
| K-1 GLO                   | LCRC L1, P19, May, 1971       |
| Lucius Lyon, 1832         | Set steel bar 43 lks. East of |
| North boundary 43 North * | SE cor. Sec. 35, 6-15         |
| of post & set cor. to     | according to records of       |
| secs. 1 & 2               | previous county surveyors     |
| Hemlock 6 S 14 W 12       | but not according to GLO      |
| Hemlock 4 S 48 E 19       | plat map                      |
|                           | Nail in 36" Maple NNE 34.37'  |
|                           | Nail in TP NE 89.54'          |
| * Assumed to be East      |                               |

Nail in TP SW 49.33'  
 SW cor. hse. fnd. NE 89.54'  
 C/L hydt. SE 38.97'  
 C/L sign SE 35.16'

B. Description of corner evidence found and/or method applied in restoring or reestablishing corner:

K-1 Found broken 4" Harrison Mon. in Mon. Box (no cover), 0.30' South of Township line  
 K-13 (SW 36) & L-13 (S 1/4 36)  
 Set conc. Nail & Ottawa Co. Remon. Tag on outside North edge of Mon. Box,  
 28.24' East of K-13 (SE 35, 6-15) on Township Line  
 SW cor. hse. fnd. NE 89.54±


And is accepted as a careful and faithful perpetuation of the position of the original corner.

PA. 843 OTTAWA COUNTY

PEER APPROVED 4/20/98

C. Description of monument for corner and accessories established to perpetuate locating the position of the corner:

K-1 Conc. Nail & Ottawa Co. Remon. Tag on outside North edge of Mon. Box on Township Line  
 Ottawa Co. Remon. Tag & Nail in NW side 20" Poplar S 60° W 75.51'  
 Ottawa Co. Remon. Tag & Nail in NW side 18" Poplar S 70° W 111.71'  
 Ottawa Co. Remon. Tag & Nail in W side 38" Maple N 20° E 111.35'  
 SW cor. hse. fnd. N 45° E 89.32'  
 C/L hydt. S 45° E 39.19'  
 C/L bit. road E-W North 1'±; on C/L bit. road South  
 Ottawa Co. Mon. in Mon. Box West 28.24' K-13 (SE 35, 6-15)

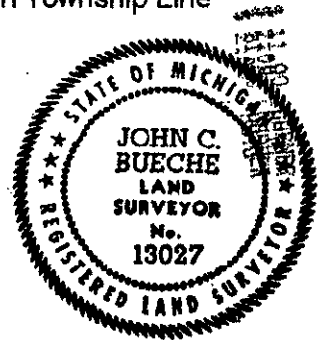

Signed by John C. Bueche, P.S. 13027  
 Surveyor's Michigan License No. \_\_\_\_\_

Date 4-1-98

SURVEY &  
REMONUMENTATION

DEC 01 1998

SECTION

