

SURVEY & REMONUMENTATION

OTTAWA COUNTY REMONUMENTATION

RECORDED

APR 25 1995

94 DEC -8 PM 12:32

COMMISSION

LAND CORNER RECORDATION CERTIFICATE

Filing Requirement of Act 74, Mich. P.A. 1970

Dorothy K. Hartman
REGISTER OF DEEDS
OTTAWA COUNTY, MI

For corners in

OTTAWA

(County)

Located In:

Corner Code #

1. Public Land Survey	T	5N	R	15W	K-5 (SE cor of Sec. 11)
	T		R		Holland Twp.
	T		R		
	T		R		
2. Property Controlling in Section	S		T	R	
	S		T	R	
3. Miscellaneous Property in Sec.	S		T	R	
	S		T	R	

Register of Deeds Stamp & File Number

1. Lot No. _____, Recorded Plat _____
2. Private Claims _____

	A	B	C	D	E	F	G	H	I	J	K	L	M
2	6	5	4	3	2	1							
3													
4	7	8	9	10	11	12							
5													
6	18	17	16	15	14	13							
7													
8	19	20	21	22	23	24							
9													
10	30	29	28	27	26	25							
11													
12	31	32	33	34	35	36							
13													

Randal J. Vugteveen, in a field survey on November 15, 1994

do hereby certify that under requirements of P.A. 74, Michigan P.A. of 1970, the corner points mentioned in lines 1 and 2 above were in conformance with regulations and rules therefore as required in the current manual of survey instructions of the United States Department of the Interior, Bureau of Land Management or by a decree of a Court of Law and/or that the corner points mentioned in lines 3, 4 and 5 above were in conformance with the rules of the Michigan Board of Land Surveyors or by a Decree of a Court of Law; established, re-established, monumented, re-monumented, recovered, found as expressed below:

NOTE: Not more than 4 corners, all in the same town and range, may be recorded on this certificate.

1. Description of original monument and accessories and/or subsequent restoration:
K-5 common corner to Sections 11, 12, 13 & 14

1832 - Brookfield	Liber 1, Page 591	Liber 5, Page 159
Set corner	Set cast iron mon.	Set Ottawa County Cast Monument
Sugar 20" S56E 23 Links	Fnd steel bar	NW 69.82' nail in SE side of P. pole
Hemlock 36" N45W 17 Links	P. pole NW 69.85'	ENE 84.26' PK nail in SE side of p. pole
	30" Maple NE 55.50'	SE 42.26' nail & cap in NE side of p. pole
	Street sign SE 43.20'	SW 46.35' nail & cap in NW side of p. pole
	P. pole SE 42.22'	
	Telephone Pole SW 46.39'	

2. Description of corner evidence found and/or method applied in restoring or reestablishing corner:
K-5 Found CIM in mon box at centerline "X" of 104th & Riley Street and accepted as a careful and faithful perpetuation of the position of the original corner


PK nail in SE side of P. pole N67E 84.32'	30" Maple NE 55.50'
Nail & cap in NW side of P. pole S39W 46.30'	Street side SE 43.20'
	Telephone pole SW 46.39'

PA. 84- OTTAWA COUNTY
PEER APPROVED 11/21/94

Randal J. Vugteveen

3. Description of monument for corner and accessories established to perpetuate locating the position of the corner:
K-5 Cast Iron Monument in Mon Box

- SW foundation corner of porch house #3216 N46E 114.80'
- NW foundation corner of house #10388 S37E 96.32'
- NE corner brick building S42W 108.72'
- SE corner concrete porch to garage N58W 149.96'
- Top hydrant N38W 50.58'

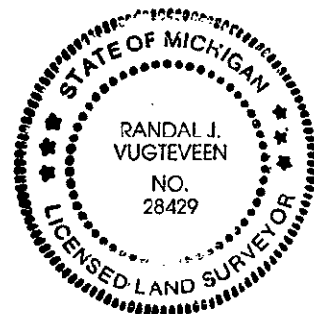

Signed by *Randal J. Vugteveen*
Surveyor's Michigan License No. 28429

Date Nov. 21, 1994