

SURVEY & REMONUMENTATION

DEC 01 1998

Ottawa County Remonumentation
LAND CORNER RECORDATION CERTIFICATE
 Filing Requirement of Act 74, Mich. P.A. 1970

RECORDED

98 JUL 21 PM 12:14


For corners in **SECTION**

<u>Ottawa</u> (County)	Located In:	Corner Code #
1. Public Land Survey	T <u>5N</u> R <u>15W</u>	<u>K-8 (W$\frac{1}{4}$, 24)</u> <u>Holland Twp.</u>
	T _____ R _____	_____
	T _____ R _____	_____
	T _____ R _____	_____
2. Property Controlling in Section	S _____ T _____ R _____	_____
	S _____ T _____ R _____	_____
3. Miscellaneous Property in Sec.	S _____ T _____ R _____	_____
	S _____ T _____ R _____	_____
4. Lot No. _____, Recorded Plat _____		
5. Private Claims _____		

Ray [Signature]
 REGISTER OF DEEDS
 OTTAWA COUNTY, MI

Register of Deeds Stamp & File Number

I, John C. Bueche, in a field survey on March 30, 19 98, do hereby certify that under requirements of P.A. 74, Michigan P.A. of 1970, the corner points mentioned in lines 1 and 2 above were in conformance with regulations and rules therefore as required in the current manual of survey instructions of the United States Department of the Interior, Bureau of Land Management or by a decree of a Court of Law and/or that the corner points mentioned in lines 3, 4 and 5 above were in conformance with the rules of the Michigan Board of Land Surveyors or by a Decree of a Court of Law; established, re-established, monumented, re-monumented, recovered, found as expressed below:

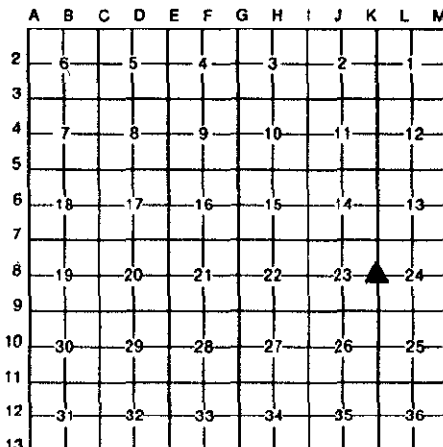

NOTE: Not more than 4 corners, all in the same town and range, may be recorded on this certificate.

A. Description of original monument and accessories and/or subsequent restoration:

K-8 GLO	LCRC 1-371, April, 1972	LCRC 3-32, Feb., 1976
Calvin Britain, 1832	Bt. spk.	Iron
North between secs. 23 & 24	TP SW 34.40'	PK PP N 40° E 41.10'
Set 1/2 mile post	PP WNW 24.27'	PK PP N 85° W 24.72'
Beech 24 S 39 E 4	PP NE 40.40'	PK UP S 30° W 34.75'
Beech 10 N 39 W 20	10" Maple SW 84.28'	
	C/L sign W. 26.51'	
	C/L E.B. M-21 North 69.7'	

B. Description of corner evidence found and/or method applied in restoring or reestablishing corner:

K-8 Found capped rerod #28407; on C/L bit. road N-S; on C/L bit. E.

Meas. E. 2662.35'

Meas. S. 2634.87'

EA. 345 OTTAWA COUNTY

PLGR APPROVED 6-1-98

TP SW 34.40'


C/L E.B. M-21 North 69.7'

UP S 30° W 34.75'

And is accepted as a careful and faithful perpetuation of the position of the original corner.

C. Description of monument for corner and accessories established to perpetuate locating the position of the corner:

K-8 Replaced capped rerod with 3/4" x 24" pin with Ottawa Co. Cap in Mon. Box
 Nail & Ottawa Co. Remon. Tag in SE side UP N 55° E 46.92'
 Nail & Ottawa Co. Remon. Tag in N side UP N 75° W 42.45'
 Nail & Ottawa Co. Remon. Tag in NW side UP S 41° W 34.65'
 Nail & Ottawa Co. Remon. Tag in W side UP S 30° E 85.25'
 Nail & Ottawa Co. Remon. Tag in N side UP S 75° E 88.94'
 C/L conc. road E-W, North 69.7'±
 On C/L bit. road N-S & E

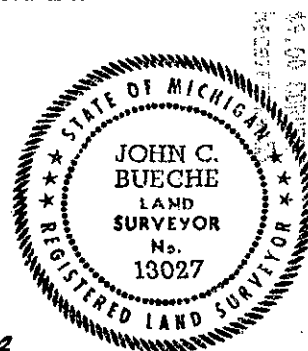

Signed by John C. Bueche, P.S.

13027

Date 4-1-98

Surveyor's Michigan License No. _____