

SURVEY & REMONUMENTATION

APR 25 1995

COMMISSION

OTTAWA COUNTY REMONUMENTATION

LAND CORNER RECORDATION CERTIFICATE
Filing Requirement of Act 74, Mich. P.A. 1970

RECORDED

94 DEC -8 PM 12:32

Robert B. Robinson
REGISTER OF DEEDS
OTTAWA COUNTY, MI

For corners in OTTAWA

(County)

Located In:

Corner Code #

- | | | | | | |
|---------------------------------------|---|----|---|-----|-------------------------------------------|
| 1. Public Land Survey | T | 5N | R | 15W | K-9 (SE cor of
Sec 23) Holland
Twp. |
| | T | | R | | |
| | T | | R | | |
| | T | | R | | |
| 2. Property Controlling
in Section | S | | T | R | |
| | S | | T | R | |
| 3. Miscellaneous
Property in Sec. | S | | T | R | |
| | S | | T | R | |
4. Lot No. _____, Recorded Plat _____
5. Private Claims _____

Register of Deeds Stamp & File Number

	A	B	C	D	E	F	G	H	I	J	K	L	M
2	6		5		4		3		2		1		
3													
4	7		8		9		10		11		12		
5													
6	18		17		16		15		14		13		
7													
8	19		20		21		22		23		24		
9													
10	30		29		28		27		26		25		
11													
12	31		32		33		34		35		36		
13													

I, Randal J. Vugteveen, in a field survey on November 15, 1994
do hereby certify that under requirements of P.A. 74, Michigan P.A. of 1970, the corner points mentioned in lines 1 and 2 above were in conformance with regulations and rules therefore as required in the current manual of survey instructions of the United States Department of the Interior, Bureau of Land Management or by a decree of a Court of Law and/or that the corner points mentioned in lines 3, 4 and 5 above were in conformance with the rules of the Michigan Board of Land Surveyors or by a Decree of a Court of Law; established, re-established, monumented, re-monumented, recovered, found as expressed below:

NOTE: Not more than 4 corners, all in the same town and range, may be recorded on this certificate.

A. Description of original monument and accessories and/or subsequent restoration:
K-9 common corner to Sections 25, 24, 23 & 22

1832 - Brookfield
Set corner
Lynn 10" S37W 7'
Locus 10" N37E 25'

Liber 1, Page 593
Found steel rod
Telephone pole NW 31.48'
"X" on headwall SW 33.34'
"X" on headwall SE 34.63'
Guy pole SE 32.52'


Liber 5, Page 284
Set O.C. cast mon. in mon box
NW 32.25' nail & cap S side of L.P.
N 99.97' PK in the centerline of road
NE 47.20' centerline top of hydrant
SE 75.30' PK W side 4" Oak
SSW 93.25' nail & cap W. side P.P.

B. Description of corner evidence found and/or method applied in restoring or reestablishing corner:
K-9 Found CIM in mon box at centerline "X" 104th & Perry and accepted as a careful and faithful perpetuation of the position of the original corner
Found LP N 53W No nails 32.42'
Centerline Hyd. Top N42E 47.26'

P.A. 345 OTTAWA COUNTY
PEER APPROVED 11/21/94
Harold P. Nedwell

C. Description of monument for corner and accessories established to perpetuate locating the position of the corner:
K-9 Cast Iron Monument in mon box

Set Ottawa County Remon Tag & Nail NE side 12" Oak S45E 79.83'
Set Ottawa County Remon Tag & Nail SE side PP N30E 68.47'
Set Ottawa County Remon Tag & Nail PP N67W 62.92'
Set Ottawa County Remon Tag & Nail SE side PP S45W 66.55'

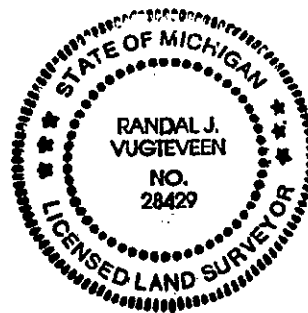

Signed by *Randal J. Vugteveen*
Surveyor's Michigan License No. 28429

Date Nov. 21, 1994