

# SURVEY & REMONUMENTATION

APR 25 1995

OTTAWA COUNTY REMONUMENTATION

RECORDED

COMMISSION

LAND CORNER RECORDATION CERTIFICATE  
Filing Requirement of Act 74, Mich. P.A. 1970

94 DEC -8 PM 12:32

For corners in OTTAWA

*Robert J. Callaway*  
REGISTER OF DEEDS  
OTTAWA COUNTY, MI

(County)	Located In:	Corner Code #
1. Public Land Survey	T <u>5N</u> R <u>15W</u>	K-10 (E 1/4 cor Sec 26) Holland Twp.
	T _____ R _____	_____
	T _____ R _____	_____
	T _____ R _____	_____
2. Property Controlling in Section	S _____ T _____ R _____	_____
	S _____ T _____ R _____	_____
3. Miscellaneous Property in Sec.	S _____ T _____ R _____	_____
	S _____ T _____ R _____	_____

Register of Deeds Stamp & File Number

4. Lot No. \_\_\_\_\_, Recorded Plat \_\_\_\_\_  
5. Private Claims \_\_\_\_\_

I, Randal J. Vugteveen, in a field survey on November 16, 1994, do hereby certify that under requirements of P.A. 74, Michigan P.A. of 1970, the corner points mentioned in lines 1 and 2 above were in conformance with regulations and rules therefore as required in the current manual of survey instructions of the United States Department of the Interior, Bureau of Land Management or by a decree of a Court of Law and/or that the corner points mentioned in lines 3, 4 and 5 above were in conformance with the rules of the Michigan Board of Land Surveyors or by a Decree of a Court of Law; established, re-established, monumented, re-monumented, recovered, found as expressed below:

**NOTE: Not more than 4 corners, all in the same town and range, may be recorded on this certificate.**

	A	B	C	D	E	F	G	H	I	J	K	L	M
2	6	5	4	3	2	1							
3													
4	7	8	9	10	11	12							
5													
6	18	17	16	15	14	13							
7													
8	19	20	21	22	23	24							
9													
10	30	29	28	27	26	25							
11													
12	31	32	33	34	35	36							
13													

**A. Description of original monument and accessories and/or subsequent restoration:**

K-10 common corner to sections 25 & 26	Liber 3, Page 305	Liber 5, Page 361
1832 - Brookfield	Pinched Pipe	O.C. cast mon.
Set post	Iron W. 33'	WNW 7.54' to SE quad inner rim to San. Mn.
Ironwood 6"	4" Ash E 41.04'	E 41.05' PK N side 6" Elm
	N end concrete culvert NE 34.20'	ESE 33.06' + on centerline top of fire hydrant
		SSW 74.15' + on centerline S. end of conc. culv.
		SE 200.94' R.L.S. nail & tag W side of PP

**B. Description of corner evidence found and/or method applied in restoring or reestablishing corner:**


K-10 Found CIM on centerline 104th Avenue and accepted as a careful and faithful perpetuation of the position of the original corner	Inner rim to Sanitary MH NW 7.45'
4" Ash E 41.04'	ESE 33.07' on centerline top of hydrant
N end concrete culvert NE 34.20'	SE 200.83' R.L.S. nail & tag W side P. pole

PA. 345 OTTAWA COUNTY  
PEER APPROVED 11/21/94

*Randal J. Vugteveen*

**C. Description of monument for corner and accessories established to perpetuate locating the position of the corner:**

K-10 Cast Iron Monument
SE foundation corner of garage house #1209 N75W 85.46'
SE foundation corner of garage house #1223 N36W 141.25'
Concrete mon West 43.00'
Top hydrant East 33.07'
Set Ottawa County Remon Tag & Nail E side P. pole S18W 156.10'
Set Ottawa County Remon Tag & Nail W side P. pole S7E 200.82'

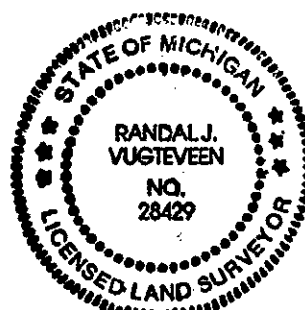

Signed by Randal J. Vugteveen  
Surveyor's Michigan License No. 28429

Date 11/21/94