

SURVEY & REMONUMENTATION

DEC 01 1998

SECTION

**OTTAWA COUNTY REMONUMENTATION
LAND CORNER RECORDATION CERTIFICATE
Filing Requirement of Act 74, Mich. P.A. 1970**

RECORDED

98 MAR 16 PM 12: 37

Darryl Williams
REGISTER OF DEEDS
OTTAWA COUNTY, MI

Register of Deeds Stamp & File Number

For corners in	OTTAWA	Located in:	Corner Code #
	(County)		
1. Public Land Survey	T5N R 15W	K-11(SE cor of Sec. 26) Holland Twp.	
	T R		
	T R		
	T R		
2. Property Controlling in Section	S T R		
	S T R		
3. Miscellaneous Property in Sec.	S T R		
	S T R		

4. Lot No. _____, Recorded Plat _____
5. Private Claims _____

I, Randal J. Vugteveen, in a field survey on December 3, 1996 do hereby state that under requirements of P.A. 74, Michigan P.A. of 1970, the corner points mentioned in lines 1 and 2 above were in conformance with regulations and rules therefore as required in the current manual of survey instructions of the United States Department of the Interior, Bureau of Land Management or by a decree of a Court of Law and for that the corner points mentioned in lines 3, 4 and 5 above were in conformance with the rules of the Michigan Board of Land Surveyors or by a Decree of a Court of Law; established, re-established, monumented, recovered, found as expressed below:

NOTE: Not more than 2 corners, all in the same town and range, may be recorded on this certificate.

A	B	C	D	E	F	G	H	I	J	K	L	M
1												
2	6	5	4	3	2	1						
3												
4	7	8	9	10	11	12						
5												
6	18	17	16	15	14	13						
7												
8	19	20	21	22	23	24						
9												
10	30	29	28	27	26	25						
11												
12	31	32	33	34	35	36						
13												

A. Description of original monument and accessories and/or subsequent restoration:

K-11 common corner to Sections 25, 26, 35 & 36
1832 - Brookfield
Set corner
Sycamore 30° S25°E 47 Links
W. Ash 10° N34°E 30 Links

Liber 1, Page 829
R.R. spike
SSE 39.60' 30" Sycamore
SW 49.55' conc. bridge rail
NW 49.9' conc. bridge rail

County surveyor records
Nederveld Assoc. South 1/4 corner, Section 25, East 2634.31'
Nederveld Assoc. East 1/4 corner, Section 26, North 2628.76'
1959 County surveyor South 1/4 corner, Section 25, East 2634.64'

B. Description of corner evidence found and/or method applied in restoring or reestablishing corner:

K-11 Found RR spike in bit @ East edge of Bridge

S 1/4 cor. Sec. 25, East 2634.39'
E 1/4 cor. Sec. 26, North 2628.72'

Accepted railroad spike as a careful perpetuation of the position of the original corner

Removed railroad spike, set 3/4"x24" solid bar with Ottawa County Remon cap in monument box


P.A. 645 OTTAWA COUNTY
PEER APPROVED 12/1/97

[Signature]

C. Description of monument for corner and accessories established to perpetuate locating the position of the corner:

K-11 Iron bar with Ottawa County Remon Cap in monument box

"X" on top concrete bridge post AZ 0° 30.81'
"X" on top concrete bridge post AZ 302° 58.58'
"X" on top concrete bridge post AZ 239° 58.68'
"X" on top concrete bridge post AZ 182° 31.16'
SE brick garage corner to House #10393 Adams AZ 39° 211.16'
On centerline Adams Street

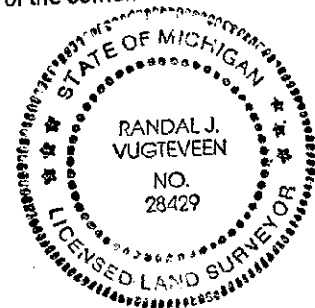

\$ 9.00 SURVEY
\$ 1.00 PHOTO

Signed by *[Signature]*
Surveyor's Michigan License No. 28429

Date Dec. 1, 1997