

SURVEY & REMONUMENTATION

OTTAWA COUNTY REMONUMENTATION

APR 25 1995

RECORDED

COMMISSION

LAND CORNER RECORDATION CERTIFICATE
Filing Requirement of Act 74, Mich. P.A. 1970

94 DEC -8 PM 12:34

or corners in OTTAWA

Dorothy Adelman
REGISTER OF DEEDS
OTTAWA COUNTY, MI

(County)	Located In:	Corner Code #
Public Land Survey	T <u>5N</u> R <u>15W</u>	K-12 (E 1/4 cor of Sec. 35) Holland Twp.
Property Controlling in Section	S _____ T _____ R _____	_____
Miscellaneous Property in Sec.	S _____ T _____ R _____	_____

Register of Deeds Stamp & File Number

Lot No. _____, Recorded Plat _____
Private Claims _____

A	B	C	D	E	F	G	H	I	J	K	L	M
2	6	5	4	3	2	1						
3												
4	7	8	9	10	11	12						
5												
6	18	17	16	15	14	13						
7												
8	19	20	21	22	23	24						
9												
10	30	29	28	27	26	25						
11												
12	31	32	33	34	35	36						
13												

Randal J. Vugteveen, in a field survey on November 16, 1994,
do hereby certify that under requirements of P.A. 74, Michigan P.A. of 1970, the corner points mentioned
in lines 1 and 2 above were in conformance with regulations and rules therefore as required in the
current manual of survey instructions of the United States Department of the Interior, Bureau of Land
Management or by a decree of a Court of Law and/or that the corner points mentioned in lines 3, 4 and 5
above were in conformance with the rules of the Michigan Board of Land Surveyors or by a Decree of a
Court of Law; established, re-established, monumented, re-monumented, recovered, found as
expressed below:

NOTE: Not more than 4 corners, all in the same town and range, may be recorded on this certificate.

Description of original monument and accessories and/or subsequent restoration:
-12 common corner to Sections 35 & 36


832 - Brookfield	Liber 5, Page 134
Set post	CIM
1" Ash 7" N50W 12'	Power Pole NW 33.03'
1" each 10" S58E 14'	Power Pole SW 42.50
	Power Pole SE 56.76'
	13" Maple ENE 79.75'

Description of corner evidence found and/or method applied in restoring or reestablishing corner:
-12 Found CIM in mon box 2.5' West of centerline "X" of 104th & Mason and accepted as a careful and faithful
perpetuation of the position of the original corner
Power pole SW 42.60'
Power pole SE 56.76'

P.A. 345 OTTAWA COUNTY
PEER APPROVED 11/21/94
Randal J. Vugteveen

Description of monument for corner and accessories established to perpetuate locating the position of the corner:
K-12 Cast Iron Monument in Mon Box

Set Ottawa County Remon Tag & Nail in S side 8" Maple N75E 76.10'
Set Ottawa County Remon Tag & Nail in N side 14" Ash S80E 87.42'
Set Ottawa County Remon Tag & Nail in SW side P. pole S47E 56.76'
Set Ottawa County Remon Tag & Nail in SE side P. Pole S27W 42.60'
Set Ottawa County Remon Tag & Nail in NE side P. pole N40W 33.27'

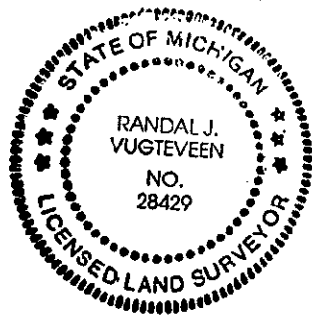

Signed by *Randal J. Vugteveen* Date Nov 21, 1994
Surveyor's Michigan License No. 28429