

SURVEY & REMONUMENTATION

OTTAWA COUNTY REMONUMENTATION

APR 25 1995

RECORDED

COMMISSION

LAND CORNER RECORDATION CERTIFICATE

94 DEC -8 PM 12:31

Filing Requirement of Act 74, Mich. P.A. 1970

For corners in OTTAWA

Polycia Robinson
REGISTER OF DEEDS
OTTAWA COUNTY, MI

(County)	Located In:	Corner Code #
1. Public Land Survey	T <u>5N</u> R <u>15W</u>	K-13 (SE cor of Sec. 35) Holland Twp.
	T _____ R _____	_____
	T _____ R _____	_____
	T _____ R _____	_____
2. Property Controlling in Section	S _____ T _____ R _____	_____
	S _____ T _____ R _____	_____
3. Miscellaneous Property in Sec.	S _____ T _____ R _____	_____
	S _____ T _____ R _____	_____

Register of Deeds Stamp & File Number

4. Lot No. _____, Recorded Plat _____
5. Private Claims _____

	A	B	C	D	E	F	G	H	I	J	K	L	M
2	6	5	4	3	2	1							
3													
4	7	8	9	10	11	12							
5													
6	18	17	16	15	14	13							
7													
8	19	20	21	22	23	24							
9													
10	30	29	28	27	26	25							
11													
12	31	32	33	34	35	36							
13													

Randal J. Vugteveen, in a field survey on November 16, 1994, do hereby certify that under requirements of P.A. 74, Michigan P.A. of 1970, the corner points mentioned in lines 1 and 2 above were in conformance with regulations and rules therefore as required in the current manual of survey instructions of the United States Department of the Interior, Bureau of Land Management or by a decree of a Court of Law and/or that the corner points mentioned in lines 3, 4 and 5 above were in conformance with the rules of the Michigan Board of Land Surveyors or by a Decree of a Court of Law; established, re-established, monumented, re-monumented, recovered, found as expressed below:

NOTE: Not more than 4 corners, all in the same town and range, may be recorded on this certificate.

1. Description of original monument and accessories and/or subsequent restoration:
K-13 common corner to Sections 35 & 36


1831 - Lyon & Sibley	Liber 3, Page 317	Liber 5, Page 48
Set post	Found 3/4" pipe	Power Pole NE 97.10'
N. Ash 16" N70E 14 Links	106.44' PK ESE in cement	Power Pole S 25.26'
Beach 6" N59W 25 Links	25.20' Power Pole S	Allegan Corner W 66.00'
	54.03' 8" Magnolia SW	16" Catalpa SW 54.08'
	66.03' 1" Pipe W	
	97.01' Power Pole NE	

2. Description of corner evidence found and/or method applied in restoring or reestablishing corner:
K-13 Found broken CIM in mon box 1' N of centerline "X" of 104th & Octagon St. and accepted as a careful and faithful perpetuation of the position of the original corner
M 106.48' to PK S75E in joint "X" of conc | Power Pole S 25.24'
under highway bridge / S 25/24' Power Pole | Catalpa stump measured 54' to side
/ 66.02' to 1" pipe West | Allegan Corner W 66.02' to 1" pipe

RA. 345 OTTAWA COUNTY
PEER APPROVED 11/21/94
Kendy P. Medowell

3. Description of monument for corner and accessories established to perpetuate locating the position of the corner:
K-13 Cast Iron Monument in Mon Box

Set Ottawa County Remon Tag & Nail in W side P. pole N28E 98.70'
Set Ottawa County Remon Tag & Nail in W side P. pole South 25.20'
Set Ottawa County Remon Tag & Nail in E side 24" Catalpa S35W 64.87'
1" Pipe - Allegan County Corner West 66.02'

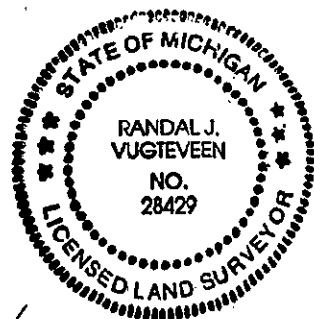

Signed by *Randal J. Vugteveen*

Date Nov. 21, 1994

Surveyor's Michigan License No. 28429