

SURVEY & REMONUMENTATION

DEC 01 1998

Ottawa County Remonumentation
LAND CORNER RECORDATION CERTIFICATE
 Filing Requirement of Act 74, Mich. P.A. 1970

RECORDED
 98 MAY 22 PM 4:06

SECTION

For corners in

<u>Ottawa</u> (County)	Located In:	Corner Code -#
1. Public Land Survey	T <u>5N</u> R <u>15W</u>	L-1 (N $\frac{1}{2}$, 1) Holland Twp.
	T _____ R _____	_____
	T _____ R _____	_____
	T _____ R _____	_____
2. Property Controlling in Section	S _____ T _____ R _____	_____
	S _____ T _____ R _____	_____
3. Miscellaneous Property in Sec.	S _____ T _____ R _____	_____
	S _____ T _____ R _____	_____

Ray Schellin
 REGISTER OF DEEDS
 OTTAWA COUNTY, MI

Register of Deeds Stamp & File Number

4. Lot No. _____, Recorded Plat _____
 5. Private Claims _____

	A	B	C	D	E	F	G	H	I	J	K	L	M
2	6	5	4	3	2	1							
3													
4	7	8	9	10	11	12							
5													
6	18	17	16	15	14	13							
7													
8	19	20	21	22	23	24							
9													
10	30	29	28	27	26	25							
11													
12	31	32	33	34	35	36							
13													

I, John C. Bueche, in a field survey on March 30, 1998, do hereby certify that under requirements of P.A. 74, Michigan P.A. of 1970, the corner points mentioned in lines 1 and 2 above were in conformance with regulations and rules therefore as required in the current manual of survey instructions of the United States Department of the Interior, Bureau of Land Management or by a decree of a Court of Law and/or that the corner points mentioned in lines 3, 4 and 5 above were in conformance with the rules of the Michigan Board of Land Surveyors or by a Decree of a Court of Law; established, re-established, monumented, re-monumented, recovered, found as expressed below:

NOTE: Not more than 4 corners, all in the same town and range, may be recorded on this certificate.

A. Description of original monument and accessories and/or subsequent restoration:

L-1 GLO
 Did not set corner
 Notes - no name or date
 Set on straight line between S 1/4 Sec. 36, 6-15 & NE cor. 1, 5-15 & 1/2 dist. between NW & NE Sec. 1
 S 1/4 is on a straight line between NE & NW 1
 On gravel road
 On C/L tree row South; S 1/4 Sec. 36 West 13.95'

B. Description of corner evidence found and/or method applied in restoring or reestablishing corner:


L-1 Found 1" solid rod in Mon. Box on C/L bit. road E-W
 On field division & tree row South 0.10' N. of Township Line
 L-13 (S 1/4 36) & M-13 (SE 36) 6-15
 S $\frac{1}{2}$ Sec. 36 West 13.95'

This position not established by original government surveyors.
 This monument is accepted as the best available evidence of the position of the corner.

PEEN APPROVED 4/20/98

C. Description of monument for corner and accessories established to perpetuate locating the position of the corner:

L-1 Set 3/4" x 24" pin with Ottawa Co. Cap in Mon. Box on Township Line (left solid rod)
 Ottawa Co. Remon. Tag & Nail in S side UP N 85° W 222.73'
 Ottawa Co. Remon. Tag & Nail in SE side UP N 16° E 32.68'
 SW cor. garg. siding N 50° W 204.58'
 SE cor. hse. fnd. N 40° W 175.53'
 On C/L of bit. road E-W; on field division & tree row South
 Ottawa Co. Mon. in Mon. Box West 14.05' L-13 (S 1/4 36, 6-15)

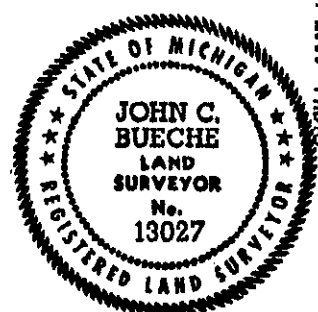

\$ 11.00 CORNER
 \$ 2.00 PHOTO

Signed by John C. Bueche Date 4-1-98
 Surveyor's Michigan License No. 13027

SURVEY &
REMONUMENTATION

DEC 01 1998

SECTION

