

FEB 24 2000

SECTION

OTTAWA COUNTY REMONUMENTATION
LAND CORNER RECORDATION CERTIFICATE
Filing Requirement of Act 74, Mich. P.A. 1970

RECORDED
99 OCT 27 PM 1:49

Long Schilt
REGISTER OF DEEDS
OTTAWA COUNTY, MI

For corners in
Ottawa _____
(County)

Located In: _____ Corner Code # _____

1. Public Land Survey T5N ___ R15W ___ L-3
T ___ R ___
T ___ R ___ North 1/4 corner
T ___ R ___ Section 12
2. Property Controlling S ___ T ___ R ___ Holland Township
in Section S ___ T ___ R ___
3. Miscellaneous S ___ T ___ R ___
Property in Sec. S ___ T ___ R ___

4. Lot No. _____, Recorded Plat _____
5. Private Claims _____

Register of Deeds Stamp & File Number

I, Steve Lampen _____, in a field survey on September 15, 1999, do hereby certify that under requirements of P.A. 74, Michigan P.A. of 1970, the corner points mentioned in lines 1 and 2 above were in conformance with regulations and rules therefore as required in the current manual of survey instructions of the United States Department of the Interior, Bureau of Land Management or by a decree of a Court of Law and/or that the corner points mentioned in lines 3, 4 and 5 above were in conformance with the rules of the Michigan Board of Land Surveyors or by a Decree of a Court of Law; established, re-established, monumented, re-monumented, recovered, found as expressed below:

NOTE: Not more than 4 corners, all in the same town and range, may be recorded on this certificate.

A. Description of original monument and accessories and/or subsequent restoration:

L-3 1969 - Greer
GLO - Brookfield - 1832 Set pipe midway
1/4 section post and on line
Sugar 10 N 47 W 11 K-3 to M-3
Sugar 9 S 50 E 17

LCRC, L3, P96 - Clapp - 1976
Foster - 1882 Found pipe, set steel bar
L-3 to K-3 = 39.72 ch 32" Maple ENE 81.35
L-3 to M-3 = 39.74 ch 28" Ash NNE 174.33
K-3 to K-2 = 40.09 ch Street sign SE 45.3
L-3 to L-2 = 40.25 ch Centerline pavement S 6'±
M-3 to M-2 = 40.25 ch

B. Description of corner evidence found and/or method applied in restoring or reestablishing corner:

L-3 Found 1" iron in monument box.
L-3 to K-3 Foster = 39.72 ch (2621.5') meas. = 2626.4
L-3 to M-3 Foster = 39.74 ch (2622.8') meas. = 2626.28
L-3 per Foster's measurement would be 0.08 ch (5.28') S of a straight line between K-3 and M-3 meas. 0.12' S of K-3 to M-3.
Several Survey's have used the found iron for the corner.

Replaced the found 1" iron with an Ottawa County Remonumentation iron and cap and accepted it as the best position of the corner.


C. Description of monument for corner and accessories established to perpetuate locating the position of the corner:

L-3 Ottawa County Remonumentation iron and cap in a monument box.
Azimuth = Michigan State Plane grid direction

Remonumentation tag in SW side light pole	143° 29'	44.84
Remonumentation tag in NW side power pole	222° 33'	51.35
Remonumentation tag in N side power pole	103° 46'	155.04
Remonumentation tag in S side 20" Maple	81° 34'	154.98
Centerline E and W asphalt road pavement	180°	9.

	A	B	C	D	E	F	G	H	I	J	K	L	M
2	6	5	4	3	2	1							
3													
4	7	8	9	10	11	12							
5													
6	18	17	16	15	14	13							
7													
8	19	20	21	22	23	24							
9													
10	30	29	28	27	26	25							
11													
12	31	32	33	34	35	36							
13													

SEALED OCTOBER 10/18/99

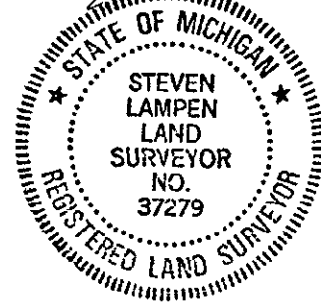

Receipt #61757

Signed by Steven Lampen Date OCTOBER 25, 1999

Surveyor's Michigan License No. 37279